



DECLARATION LEGEND
SUB-PHASE 2E
 LCE 22 = 3,350 S.F.
 COMMON ELEMENT = 106,135± S.F.

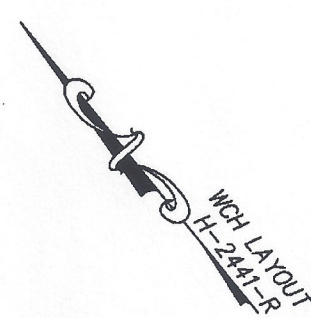

PLAN REFERENCE:
 PLAN BOOK , PLAN

I CERTIFY THAT THIS PLAN SHOWS THE UNIT BEING CONVEYED AND OF IMMEDIATE ADJOINING UNITS, AND THAT IT FULLY AND ACCURATELY DEPICTS THE LAYOUT, LOCATION, DIMENSIONS, APPROXIMATE AREA, UNIT NUMBER, MAIN ENTRANCE, AND IMMEDIATE COMMON AREA TO WHICH IT HAS ACCESS, AS BUILT.

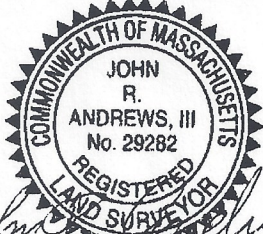

John R. Andrews, III 6/30/09
 JOHN R. ANDREWS, III, P.L.S. DATE

SUMMERFIELD AT TAFT HILL CONDOMINIUM - SUB-PHASE 2E
SUMMERFIELD DRIVE, UXBRIDGE, MA

VILLAGE UNIT PLAN - UNIT 22 SUMMERFIELD DR.

Andrews Survey & Engineering, Inc.
 Land Surveying Civil Engineering Site Planning
ASE
 P.O. Box 252, 104 Mendon Street
 Uxbridge, Massachusetts 01569-0312
 P: 508-278-3997 F: 508-278-2289

REVISIONS:	SCALE: 1"=20'	DATE: 6/23/09
	DRAWN BY: TRB	CHK'D BY: JRA
41 Summerfield	JOB: 2004-439	FILE: PHASE 2E_rev(6)

ATTEST: WORC. Anthony J. Vigliotti, Register