



DECLARATION LEGEND
SUB-PHASE 2D
 LCE 10 = 3,383 S.F.
 COMMON ELEMENT = 73,009± S.F.

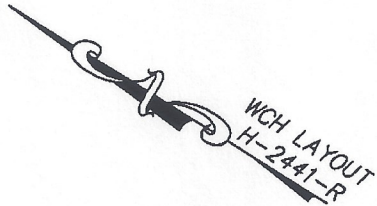

PLAN REFERENCE:
 PLAN BOOK 853, PLAN 12

I CERTIFY THAT THIS PLAN SHOWS THE UNIT BEING CONVEYED AND OF IMMEDIATE ADJOINING UNITS, AND THAT IT FULLY AND ACCURATELY DEPICTS THE LAYOUT, LOCATION, DIMENSIONS, APPROXIMATE AREA, UNIT NUMBER, MAIN ENTRANCE, AND IMMEDIATE COMMON AREA TO WHICH IT HAS ACCESS, AS BUILT.

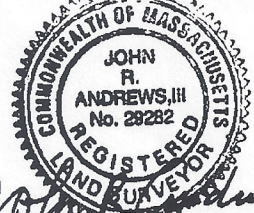

John R. Andrews, III 1/24/07
 JOHN R. ANDREWS, III, P.L.S. DATE

SUMMERFIELD AT TAFT HILL CONDOMINIUM - SUB-PHASE 2D
SUMMERFIELD DRIVE, UXBRIDGE, MA

VILLAGE UNIT PLAN - UNIT 10 SUMMERFIELD DR.

REVISIONS:	SCALE: 1"=20'	1/23/07
	DRAWN BY: TRB	CHK'D BY: JRA
23 Summerfield	JOB: 2004-439	FILE: phase2D_revised

Andrews Survey & Engineering, Inc.
 Land Surveying, Civil Engineering, Site Planning
ASPE
 P.O. Box 312, 104 Mendon Street
 Uxbridge, Massachusetts 01569-0312
 P: 508-278-3897 F: 508-278-2289

ATTEST: WONG Anthony J. Vignotti, Register