


DECLARATION LEGEND

<u>SUB-PHASE 4B</u> LCE 114 = 4,124 S.F. COMMON ELEMENT = 226,610± S.F.



PLAN REFERENCE: PLAN BOOK , PLAN

I CERTIFY THAT THIS PLAN SHOWS THE UNIT BEING CONVEYED AND OF IMMEDIATE ADJOINING UNITS, AND THAT IT FULLY AND ACCURATELY DEPICTS THE LAYOUT, LOCATION, DIMENSIONS, APPROXIMATE AREA, UNIT NUMBER, MAIN ENTRANCE, AND IMMEDIATE COMMON AREA TO WHICH IT HAS ACCESS, AS BUILT.

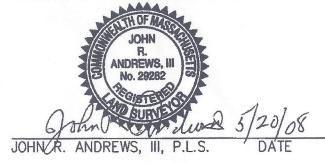

SUMMERFIELD AT TAFT HILL CONDOMINIUM - SUB-PHASE 4B ANDREWS DRIVE, UXBRIDGE, MA

DOVER UNIT PLAN - UNIT 114 ANDREWS DRIVE

REVISIONS:

SCALE: 1'=20'

DATE: 5-19-08

DRAWN BY: TRB CHK'D BY: JRA

JOB: 2004-439 FILE: PHASE4B_REV

