


DECLARATION LEGEND


SUB-PHASE 3E

LCE 76 = 3,991 S.F.
 COMMON ELEMENT = 8,155± S.F.

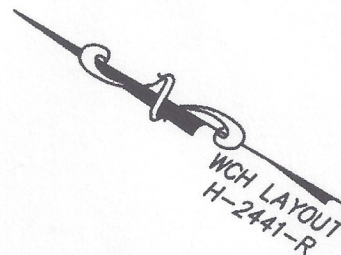

PLAN REFERENCE:
 PLAN BOOK , PLAN

I CERTIFY THAT THIS PLAN SHOWS THE UNIT BEING CONVEYED AND OF IMMEDIATE ADJOINING UNITS, AND THAT IT FULLY AND ACCURATELY DEPICTS THE LAYOUT, LOCATION, DIMENSIONS, APPROXIMATE AREA, UNIT NUMBER, MAIN ENTRANCE, AND IMMEDIATE COMMON AREA TO WHICH IT HAS ACCESS, AS BUILT.

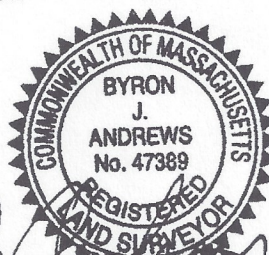

Byron J. Andrews 7/30/14

**SUMMERFIELD AT TAFT HILL CONDOMINIUM - SUB-PHASE 3E
 TAFT HILL LANE, UXBRIDGE, MA**

COTTAGE UNIT PLAN - UNIT 76 TAFT HILL LANE

REVISIONS:	SCALE: 1' = 20'	DATE: 7/30/14
147 THL	DRAWN BY: TRB	CHK'D BY: JRA
	JOB: 2004-439	FILE: PHASE3E.dwg

Andrews Survey & Engineering, Inc.
 Land Surveying • Civil Engineering • Site Planning

P.O. Box 312, 104 Mendon Street
 Uxbridge, Massachusetts 01569-0312
 P: 508-278-3897 F: 508-278-2289

