



**DECLARATION LEGEND**  
**SUB-PHASE 3D**  
 LCE 70 = 3,469 S.F.  
 COMMON ELEMENT = 18,237± S.F.

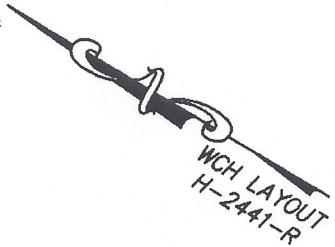

PLAN REFERENCE:  
 PLAN BOOK , PLAN

I CERTIFY THAT THIS PLAN SHOWS THE UNIT BEING CONVEYED AND OF IMMEDIATE ADJOINING UNITS, AND THAT IT FULLY AND ACCURATELY DEPICTS THE LAYOUT, LOCATION, DIMENSIONS, APPROXIMATE AREA, UNIT NUMBER, MAIN ENTRANCE, AND IMMEDIATE COMMON AREA TO WHICH IT HAS ACCESS, AS BUILT.

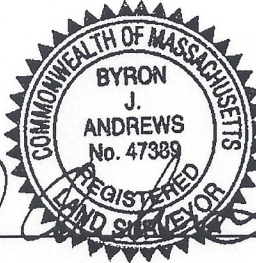

*Byron J. Andrews* 7/30/14

**SUMMERFIELD AT TAFT HILL CONDOMINIUM - SUB-PHASE 3D  
 TAFT HILL LANE, UXBRIDGE, MA**

**DOVER UNIT PLAN - UNIT 70 TAFT HILL LANE**

REVISIONS:	SCALE: 1"=20'	DATE: 7/30/14
	DRAWN BY: TRB	CHK'D BY: JRA
140 THL	JOB: 2004-439	FILE: PHASE3D&5D.dwg

**Andrews Survey & Engineering, Inc.**  
 Land Surveying & Civil Engineering - Site Planning  
 P.O. Box 212, 104 Mendon Street  
 Uxbridge, Massachusetts 01569-0312  
 P: 508-278-3897 F: 508-278-2289

ATTEST: WORC. Anthony J. Vigliotti, Register