


DECLARATION LEGEND

<u>SUB-PHASE 3C</u> LCE 127 = 4,939 S.F. COMMON ELEMENT = 21,848± S.F.



PLAN REFERENCE: PLAN BOOK , PLAN

I CERTIFY THAT THIS PLAN SHOWS THE UNIT BEING CONVEYED AND OF IMMEDIATE ADJOINING UNITS, AND THAT IT FULLY AND ACCURATELY DEPICTS THE LAYOUT, LOCATION, DIMENSIONS, APPROXIMATE AREA, UNIT NUMBER, MAIN ENTRANCE, AND IMMEDIATE COMMON AREA TO WHICH IT HAS ACCESS, AS BUILT.

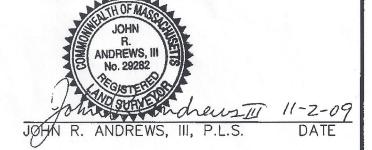

SUMMERFIELD AT TAFT HILL CONDOMINIUM - SUB-PHASE 3C TAFT HILL LANE, UXBRIDGE, MA

VILLAGE UNIT PLAN - UNIT 127 TAFT HILL LANE

REVISIONS: SCALE: 1'=20' DATE: 10/30/09

DRAWN BY: TRB CHK'D BY: JRA

127 Taft Hill and JOB: 2004-439 FILE: PHASE3C_REV



Unbridge, Massachusetts 01569-0312 P: 508-278-3897 ⇒F: 508-278-2289