

SUB-PHASE 4E COMMON ELEMENT


DECLARATION LEGEND

SUB-PHASE 3D

LCE 68 = 3,281 S.F.

COMMON ELEMENT = 28,862± S.F.


SUB-PHASE 4E COMMON ELEMENT

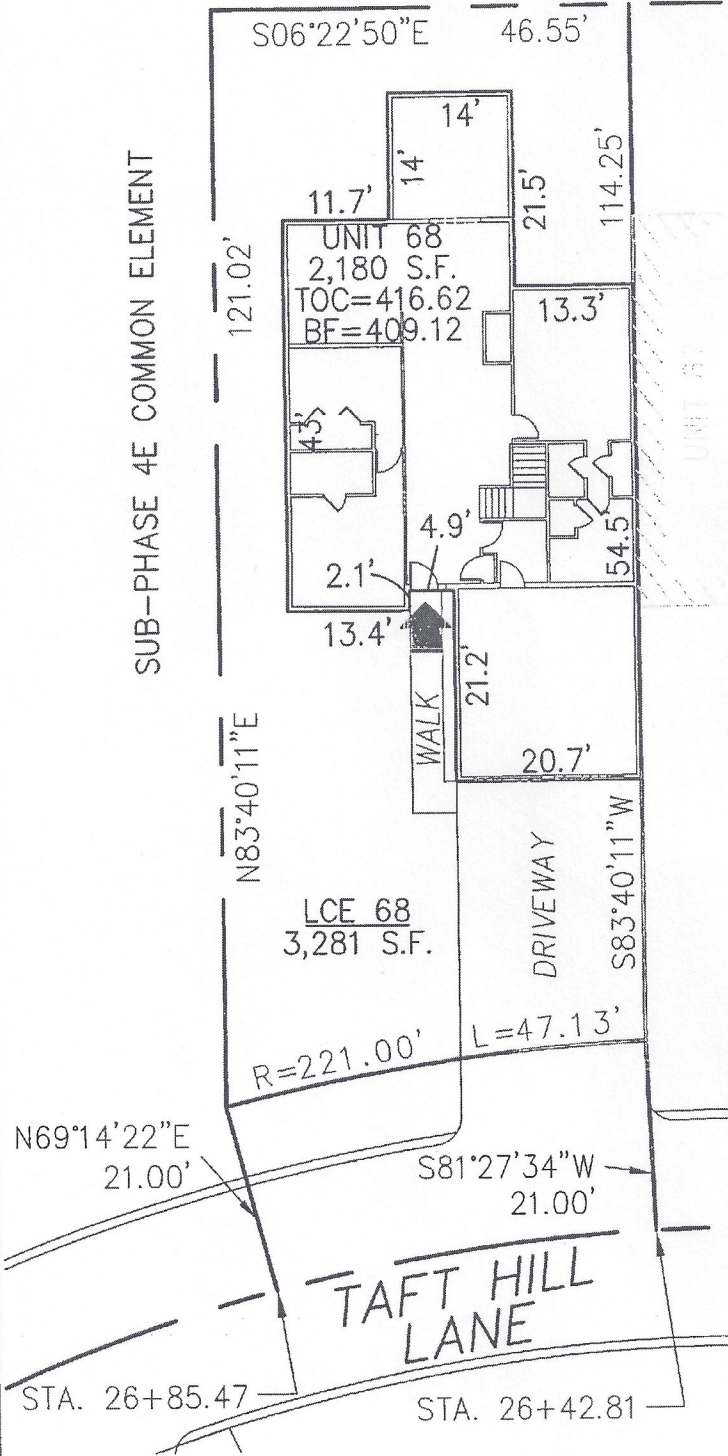

WCH LAYOUT
H-2441-R

PLAN REFERENCE:
PLAN BOOK , PLAN

I CERTIFY THAT THIS PLAN SHOWS THE UNIT BEING CONVEYED AND OF IMMEDIATE ADJOINING UNITS, AND THAT IT FULLY AND ACCURATELY DEPICTS THE LAYOUT, LOCATION, DIMENSIONS, APPROXIMATE AREA, UNIT NUMBER, MAIN ENTRANCE, AND IMMEDIATE COMMON AREA TO WHICH IT HAS ACCESS, AS BUILT.

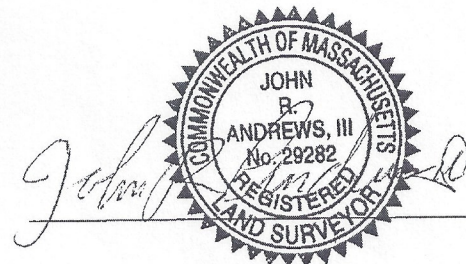

SUMMERFIELD AT TAFT HILL CONDOMINIUM - SUB-PHASE 3D
TAFT HILL LANE, UXBRIDGE, MA

VILLAGE UNIT PLAN - UNIT 68 TAFT HILL LANE

Andrews Survey & Engineering, Inc.
Land Surveying - Civil Engineering - Site Planning

REVISIONS:	SCALE: 1"=20'	DATE: 11/28/12
	DRAWN BY: TRB	CHK'D BY: JRA
135 Taft Hill Lane	JOB: 2004-439	FILE: PHASE3D_REV

P.O. Box 312, 104 Mendon Street
Uxbridge, Massachusetts 01569-0312
P: 508-278-3897 F: 508-278-2289