

DECLARATION LEGEND


SUB-PHASE 1E

LCE 45 = 4,411 S.F.
COMMON ELEMENT = 61,054± S.F.


*WCH LAYOUT
H-2441-R*

PLAN REFERENCE:
PLAN BOOK , PLAN

I CERTIFY THAT THIS PLAN SHOWS THE UNIT BEING CONVEYED AND OF IMMEDIATE ADJOINING UNITS, AND THAT IT FULLY AND ACCURATELY DEPICTS THE LAYOUT, LOCATION, DIMENSIONS, APPROXIMATE AREA, UNIT NUMBER, MAIN ENTRANCE, AND IMMEDIATE COMMON AREA TO WHICH IT HAS ACCESS, AS BUILT.

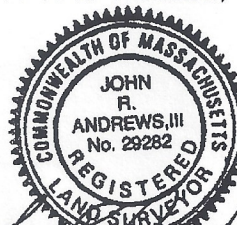

John R. Andrews, III 2/28/06
JOHN R. ANDREWS, III, P.L.S. DATE

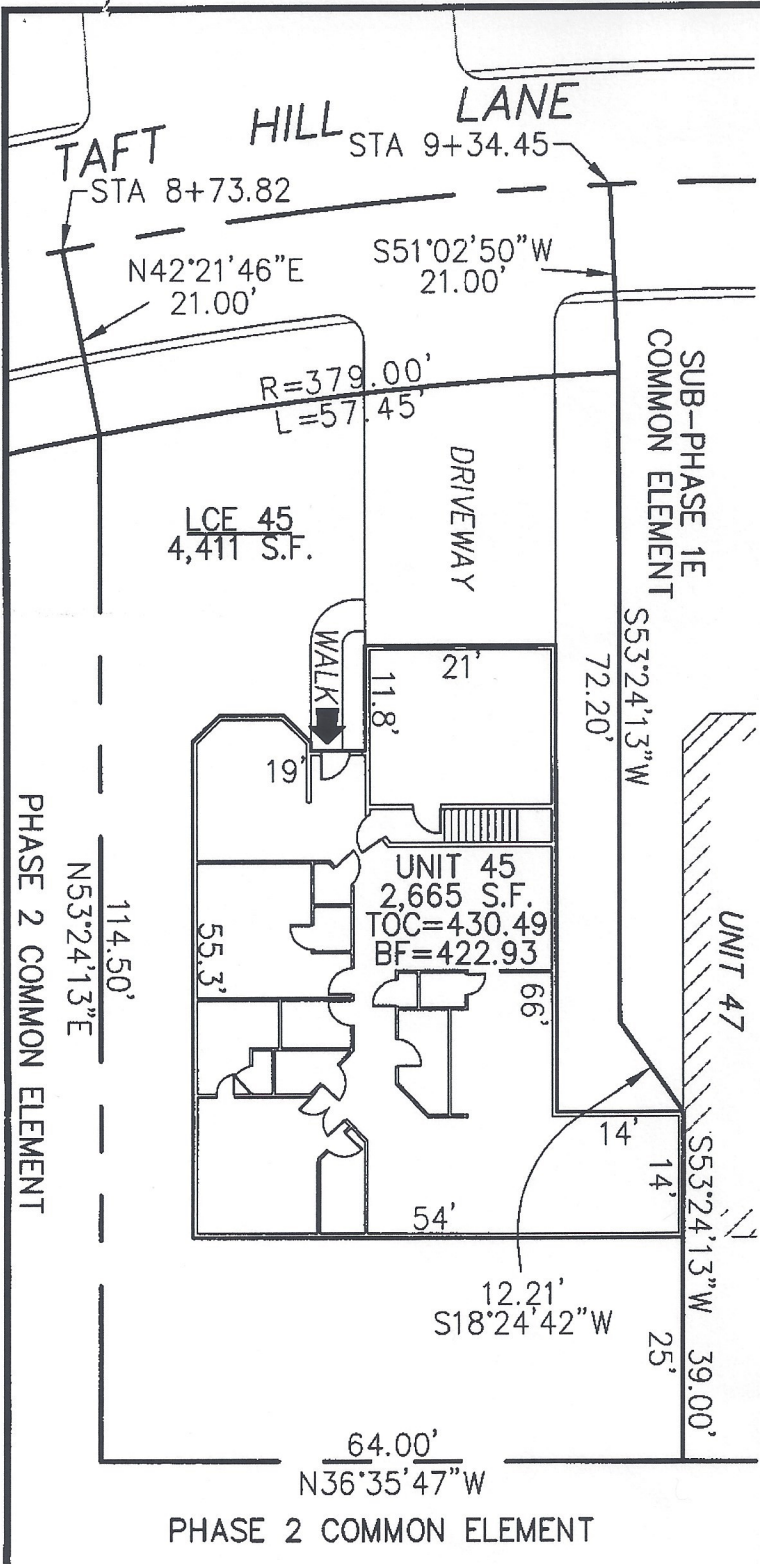

**SUMMERFIELD AT TAFT HILL CONDOMINIUM - SUB-PHASE 1E
TAFT HILL LANE, UXBRIDGE, MA**

FAIRWAY UNIT PLAN - 45 TAFT HILL LANE

Andrews Survey & Engineering, Inc.
Land Surveying Civil Engineering Site Planning
ASE
P.O. Box 312, 104 Mendon Street
Uxbridge, Massachusetts 01569-0312
P: 508-278-3897 F: 508-278-2289

REVISIONS:	SCALE: 1"=20'	DATE: 2-27-06
	DRAWN BY: SJO	CHK'D BY: JRA
<i>45 Taft Hill Lane</i>	JOB: 2004-439	FILE: phase1E

ATTEST: WORC. ANTHONY J. VIGNOLI, REGISTRAR