
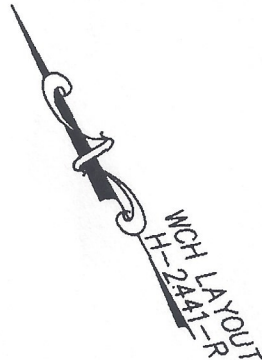


SUB-PHASE 1A
COMMON ELEMENT


DECLARATION LEGEND

SUB-PHASE 1A
LCE 36 = 4,384 S.F.
COMMON ELEMENT = 310,463± S.F.

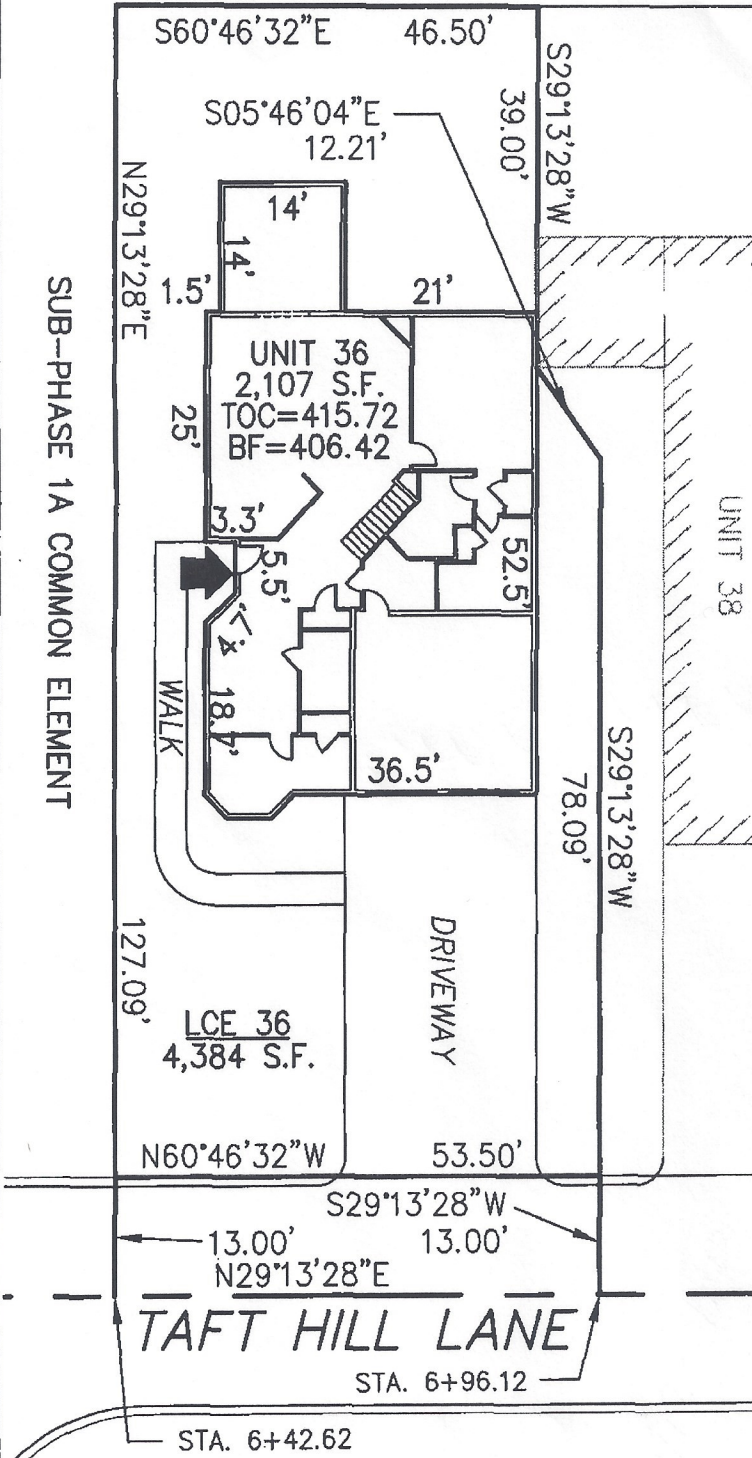

PLAN REFERENCE:
PLAN BOOK , PLAN

I CERTIFY THAT THIS PLAN SHOWS THE UNIT BEING CONVEYED AND OF IMMEDIATE ADJOINING UNITS, AND THAT IT FULLY AND ACCURATELY DEPICTS THE LAYOUT, LOCATION, DIMENSIONS, APPROXIMATE AREA, UNIT NUMBER, MAIN ENTRANCE, AND IMMEDIATE COMMON AREA TO WHICH IT HAS ACCESS, AS BUILT.

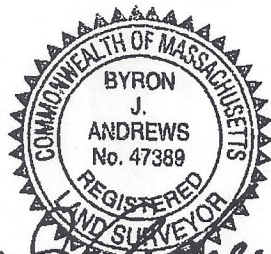

Byron J. Andrews 12/21/12

SUMMERFIELD AT TAFT HILL CONDOMINIUM - SUB-PHASE 1A
TAFT HILL LANE, UXBRIDGE, MA

DOVER UNIT PLAN - 36 TAFT HILL LANE

Andrews Survey & Engineering, Inc.
Land Surveying • Civil Engineering • Site Planning

REVISIONS:	SCALE: 1"=20'	DATE: 12/20/12
	DRAWN BY: TRB	CHK'D BY: JRA
36 THL	JOB: 2004-439	FILE: PHASE 1A_rev(3)

P.O. Box 312, 104 Mendon Street
Uxbridge, Massachusetts 01569-0312
P: 508-278-3897 F: 508-278-2289

ATTEST: WORC. Anthony J. Vighetto, Register