
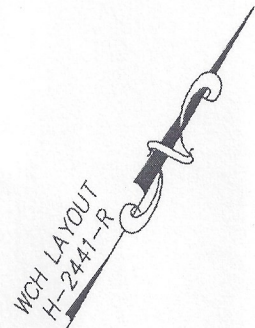


DECLARATION LEGEND

SUB-PHASE 4E


LCE 130 = 4,972 S.F.

COMMON ELEMENT = 36,994± S.F.

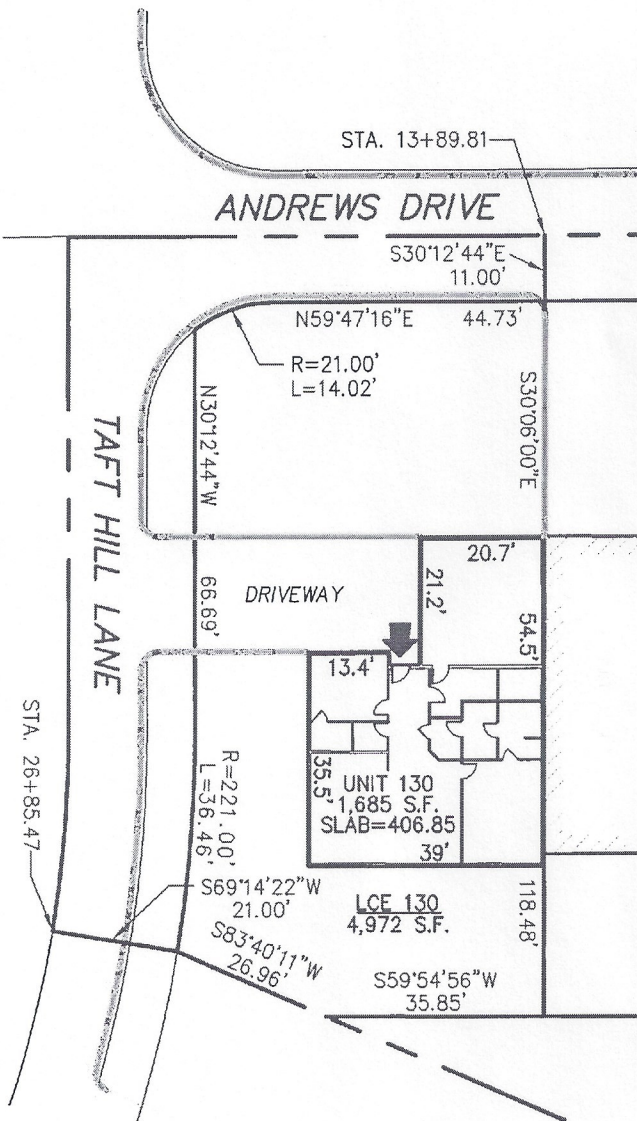

PLAN REFERENCE:
PLAN BOOK _____, PLAN _____

I CERTIFY THAT THIS PLAN SHOWS THE UNIT BEING CONVEYED AND OF IMMEDIATE ADJOINING UNITS, AND THAT IT FULLY AND ACCURATELY DEPICTS THE LAYOUT, LOCATION, DIMENSIONS, APPROXIMATE AREA, UNIT NUMBER, MAIN ENTRANCE, AND IMMEDIATE COMMON AREA TO WHICH IT HAS ACCESS, AS BUILT.

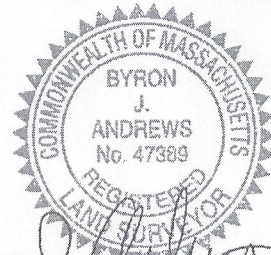

Byron J. Andrews 7/24/15

SUMMERFIELD AT TAFT HILL CONDOMINIUM - SUB-PHASE 4E ANDREWS DRIVE, UXBRIDGE, MA

COTTAGE UNIT PLAN - UNIT 130 ANDREWS DR.

Andrews Survey & Engineering, Inc.
Land Surveying - Civil Engineering - Site Planning

REVISIONS:	SCALE: 1' = 30'	DATE: 10/8/13
	DRAWN BY: TRB	CHK'D BY: JRA
70 Andrews Drive	JOB: 2004-439	FILE: PHASE4E_REV.dwg

P.O. Box 312, 104 Mendon Street
Uxbridge, Massachusetts 01569-0312
P: 508-278-3897 F: 508-278-2289