


DECLARATION LEGEND

SUB-PHASE 2D


LCE 9 = 3,393 S.F.

COMMON ELEMENT = 90,241± S.F.

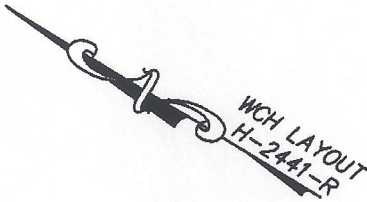

PLAN REFERENCE:
PLAN BOOK , PLAN

I CERTIFY THAT THIS PLAN SHOWS THE UNIT BEING CONVEYED AND OF IMMEDIATE ADJOINING UNITS, AND THAT IT FULLY AND ACCURATELY DEPICTS THE LAYOUT, LOCATION, DIMENSIONS, APPROXIMATE AREA, UNIT NUMBER, MAIN ENTRANCE, AND IMMEDIATE COMMON AREA TO WHICH IT HAS ACCESS AS BUILT.

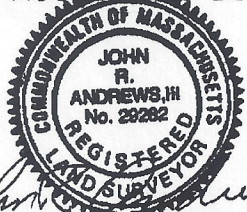

John R. Andrews, III
JOHN R. ANDREWS, III, P.L.S. DATE 11/1/06

**SUMMERFIELD AT TAFT HILL CONDOMINIUM - SUB-PHASE 2D
SUMMERFIELD DRIVE, UXBRIDGE, MA**

VILLAGE UNIT PLAN - UNIT 9 SUMMERFIELD DR.

REVISIONS:	SCALE: 1"=20'	10-31-06
	DRAWN BY: TRB	CHK'D BY: JRA
21 Summerfield	JOB: 2004-439	FILE: phase2D

Andrews Survey & Engineering, Inc.
Land Surveying, Civil Engineering, Site Planning

ASPE

Post Box 222, Taft Hill Condominium
Uxbridge, Massachusetts 01569-0312
P: 508-278-3297 F: 508-278-2289

ATTEST: WORC. Anthony J. Viglietti, Register