


SUB-PHASE 1A COMMON ELEMENT

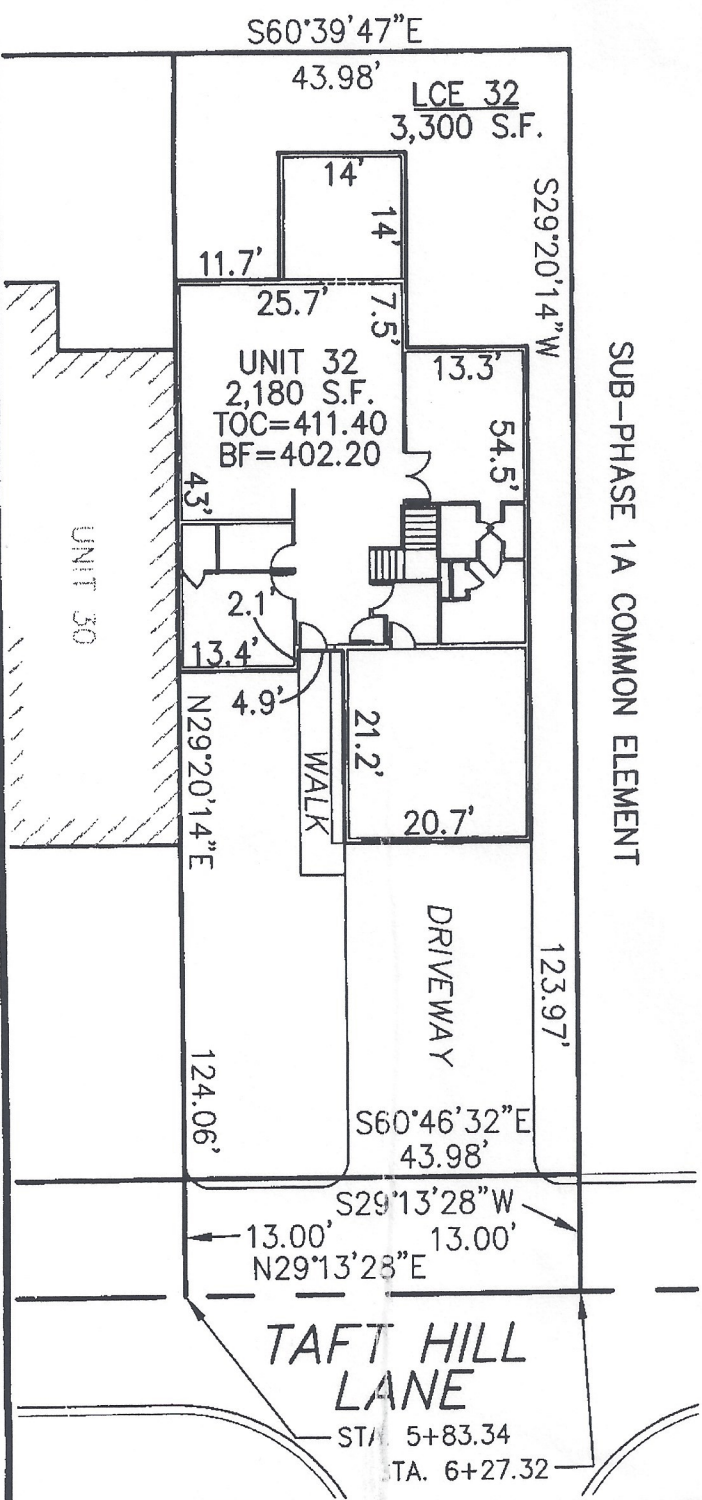

DECLARATION LEGEND

SUB-PHASE 1A


LCE 32 = 3,300 S.F.

COMMON ELEMENT = 310,463± S.F.



PLAN REFERENCE:
PLAN BOOK , PLAN

I CERTIFY THAT THIS PLAN SHOWS THE UNIT BEING CONVEYED AND OF IMMEDIATE ADJOINING UNITS, AND THAT IT FULLY AND ACCURATELY DEPICTS THE LAYOUT, LOCATION, DIMENSIONS, APPROXIMATE AREA, UNIT NUMBER, MAIN ENTRANCE, AND IMMEDIATE COMMON AREA TO WHICH IT HAS ACCESS, AS BUILT.

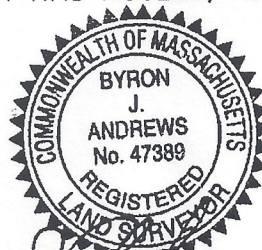

Byron J. Andrews 12/21/2012

SUMMERFIELD AT TAFT HILL CONDOMINIUM - SUB-PHASE 1A
TAFT HILL LANE, UXBRIDGE, MA

VILLAGE UNIT PLAN - 32 TAFT HILL LANE

Andrews Survey & Engineering, Inc.
Land Surveying Civil Engineering Site Planning

REVISIONS:	SCALE: 1"=20'	DATE: 12/20/12
	DRAWN BY: TRB	CHK'D BY: JRA
32 Taft Hill Lane	JOB: 2004-439	FILE: PHASE 1A_rev(3)

P.O. Box 912, 104 Mendon Street
Uxbridge, Massachusetts 01569-0312
P: 508-278-3897 F: 508-278-2289