

DECLARATION LEGEND

SUB-PHASE 5E


LCE 78 = 3,491 S.F.

COMMON ELEMENT = 91,180± S.F.




PLAN REFERENCE:
PLAN BOOK , PLAN

I CERTIFY THAT THIS PLAN SHOWS THE UNIT BEING CONVEYED AND OF IMMEDIATE ADJOINING UNITS, AND THAT IT FULLY AND ACCURATELY DEPICTS THE LAYOUT, LOCATION, DIMENSIONS, APPROXIMATE AREA, UNIT NUMBER, MAIN ENTRANCE, AND IMMEDIATE COMMON AREA TO WHICH IT HAS ACCESS, AS BUILT.

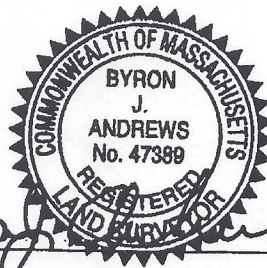

Byron J. Andrews 1/28/14

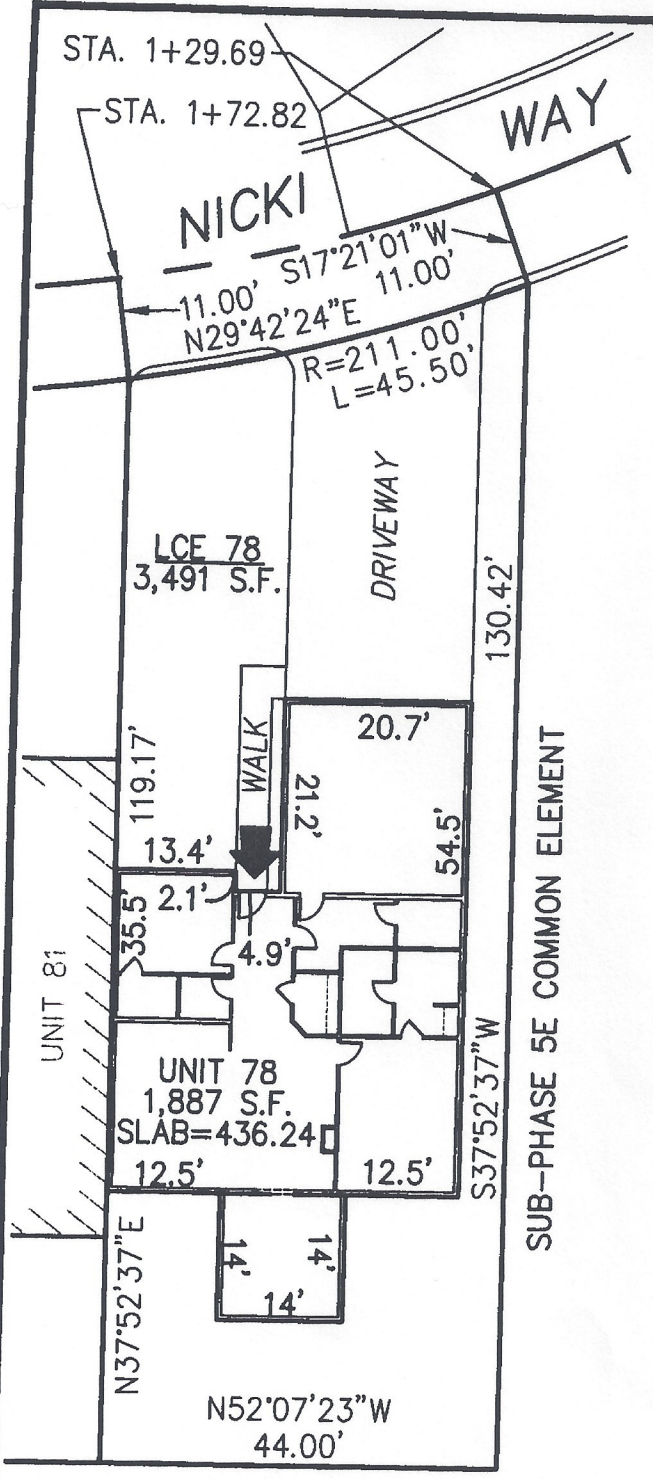

SUB-PHASE 5E
COMMON ELEMENT

**SUMMERFIELD AT TAFT HILL CONDOMINIUM - SUB-PHASE 5E
NICKI WAY, UXBRIDGE, MA**

COTTAGE UNIT PLAN - UNIT 78 NICKI WAY

REVISIONS:	SCALE: 1"=20'	DATE: 1/27/14
8 Nicki	DRAWN BY: TRB	CHK'D BY: BJA
	JOB: 2004-439	FILE: PHASE5E.dwg

Andrews Survey & Engineering, Inc.
Land Surveying - Civil Engineering - Site Planning
ASPE
P.O. Box 312, 104 Mendon Street
Uxbridge, Massachusetts 01569-0312
P: 508-278-3897 F: 508-278-2289