

DECLARATION LEGEND

SUB-PHASE 3B


LCE 53 = 4,862 S.F.

COMMON ELEMENT = 56,185± S.F.

WCH LAYOUT
H-2441-R


PLAN REFERENCE:
PLAN BOOK , PLAN

I CERTIFY THAT THIS PLAN SHOWS THE UNIT BEING CONVEYED AND OF IMMEDIATE ADJOINING UNITS, AND THAT IT FULLY AND ACCURATELY DEPICTS THE LAYOUT, LOCATION, DIMENSIONS, APPROXIMATE AREA, UNIT NUMBER, MAIN ENTRANCE, AND IMMEDIATE COMMON AREA TO WHICH IT HAS ACCESS, AS BUILT.

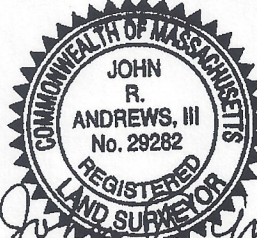

JOHN R. ANDREWS, III, P.L.S.

9/18/08
DATE

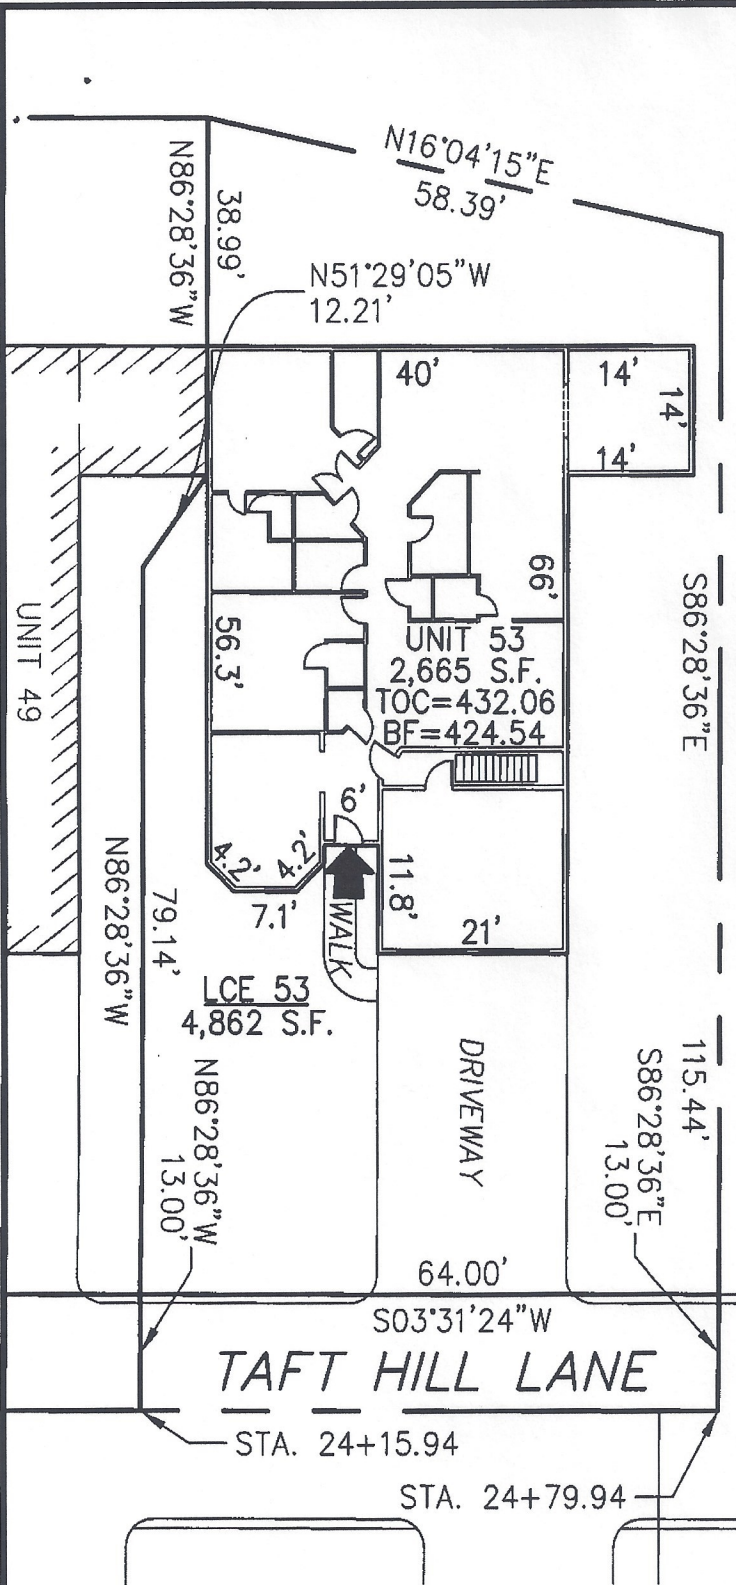

**SUMMERFIELD AT TAFT HILL CONDOMINIUM - SUB-PHASE 3B
TAFT HILL LANE, UXBRIDGE, MA**

FAIRWAY UNIT PLAN - UNIT 53 TAFT HILL LANE

Andrews Survey & Engineering, Inc.
Land Surveying Civil Engineering Site Planning

ASE
P.O. Box 112, 104 Mendon Street
Uxbridge, Massachusetts 01569-0312
P: 508-278-3897 F: 508-278-2289

REVISIONS:	SCALE: 1"=20'	DATE: 9-15-08
	DRAWN BY: TRB	CHK'D BY: JRA
124 Taft Hill Lane	JOB: 2004-439	FILE: PHASE3B

ATTEST: WORC. Anthony J. Vigliotti, Register