



DECLARATION LEGEND

SUB-PHASE 2E
 LCE 21 = 3,335 S.F.
 COMMON ELEMENT = 133,568± S.F.

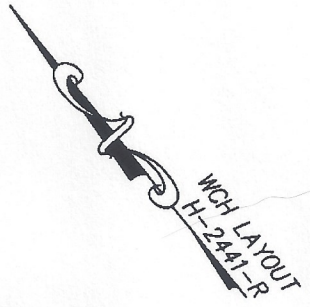

PLAN REFERENCE:
 PLAN BOOK , PLAN

I CERTIFY THAT THIS PLAN SHOWS THE UNIT BEING CONVEYED AND OF IMMEDIATE ADJOINING UNITS, AND THAT IT FULLY AND ACCURATELY DEPICTS THE LAYOUT, LOCATION, DIMENSIONS, APPROXIMATE AREA, UNIT NUMBER, MAIN ENTRANCE, AND IMMEDIATE COMMON AREA TO WHICH IT HAS ACCESS, AS BUILT.

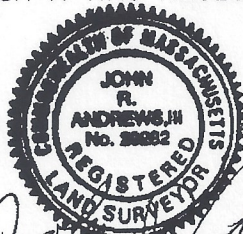

John R. Andrews, III 4/28/08
 JOHN R. ANDREWS, III, P.L.S. DATE

**SUMMERFIELD AT TAFT HILL CONDOMINIUM - SUB-PHASE 2E
 SUMMERFIELD DRIVE, UXBRIDGE, MA**

VILLAGE UNIT PLAN - UNIT 21 SUMMERFIELD DR.			Andrews Survey & Engineering, Inc. Land Surveying Civil Engineering Site Planning	
REVISIONS:	SCALE: 1"=20'	DATE: 4/22/08	 P.O. Box 212, 104 Mendon Street Uxbridge, Massachusetts 01569-0312 P: 508-278-3297 F: 508-278-2289	
	DRAWN BY: TRB	CHK'D BY: JRA		
<i>39 Summerfield</i>	JOB: 2004-439	FILE: PHASE 2E_rev(2)		

ATTEST: WORC. Anthony J. Vigliotti, Register