

SUB-PHASE 4E COMMON ELEMENT

DECLARATION LEGEND

SUB-PHASE 3D


LCE 67 = 2,873 S.F.

COMMON ELEMENT = 23,834± S.F.


WCH LAYOUT
H-2441-R

PLAN REFERENCE:
PLAN BOOK , PLAN

I CERTIFY THAT THIS PLAN SHOWS THE UNIT BEING CONVEYED AND OF IMMEDIATE ADJOINING UNITS, AND THAT IT FULLY AND ACCURATELY DEPICTS THE LAYOUT, LOCATION, DIMENSIONS, APPROXIMATE AREA, UNIT NUMBER, MAIN ENTRANCE, AND IMMEDIATE COMMON AREA TO WHICH IT HAS ACCESS, AS BUILT.

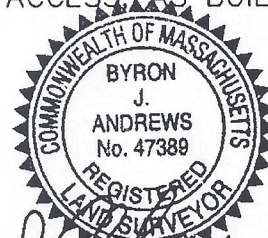

Byron J. Andrews 12/21/12

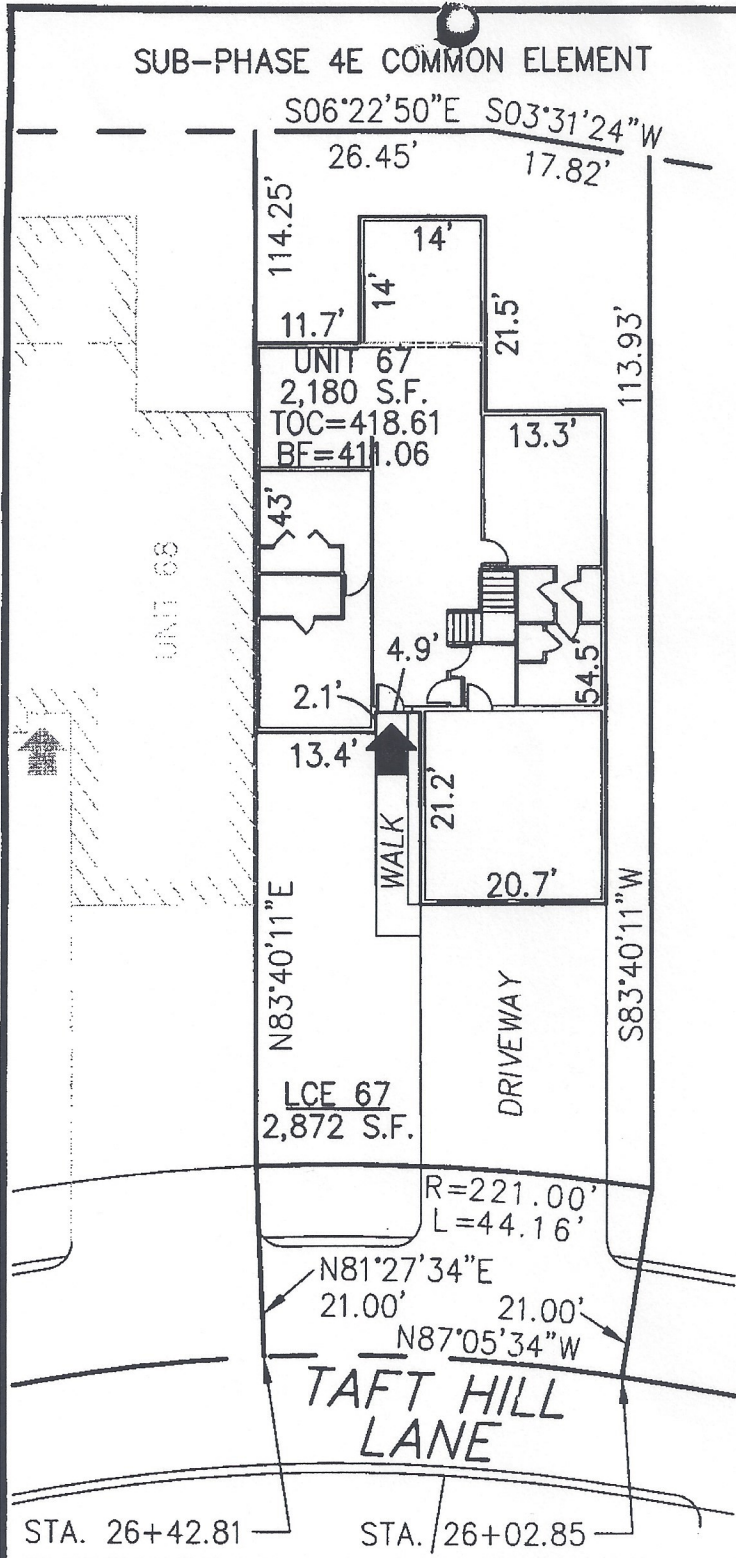

SUMMERFIELD AT TAFT HILL CONDOMINIUM - SUB-PHASE 3D
TAFT HILL LANE, UXBRIDGE, MA

VILLAGE UNIT PLAN - UNIT 67 TAFT HILL LANE

Andrews Survey & Engineering, Inc.
Land Surveying Civil Engineering Site Planning

REVISIONS:	SCALE: 1"=20'	DATE: 12/19/12
	DRAWN BY: TRB	CHK'D BY: JRA
133 THL	JOB: 2004-439	FILE: PHASE3D_4C

P.O. Box 542, 104 Mendon Street
Uxbridge, Massachusetts 01569-0312
P: 508-278-3897 F: 508-278-2289

ATTEST: WORC. Anthony J. Vigilotti, Register