



DECLARATION LEGEND

SUB-PHASE 5B
 LCE 92 = 4,596 S.F.
 COMMON ELEMENT = 13,683± S.F.

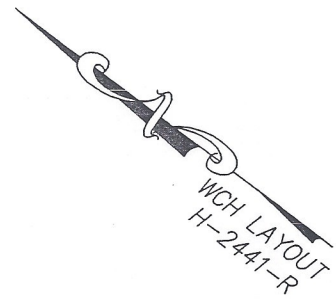

PLAN REFERENCE:
 PLAN BOOK , PLAN

I CERTIFY THAT THIS PLAN SHOWS THE UNIT BEING CONVEYED AND OF IMMEDIATE ADJOINING UNITS, AND THAT IT FULLY AND ACCURATELY DEPICTS THE LAYOUT, LOCATION, DIMENSIONS, APPROXIMATE AREA, UNIT NUMBER, MAIN ENTRANCE, AND IMMEDIATE COMMON AREA TO WHICH IT HAS ACCESS, AS BUILT.

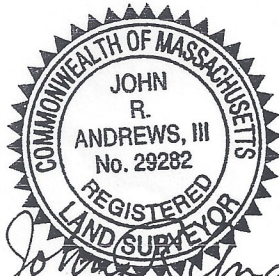

John R. Andrews III

**SUMMERFIELD AT TAFT HILL CONDOMINIUM - SUB-PHASE 5B
 NICKI WAY, UXBRIDGE, MA**

DOVER UNIT PLAN - UNIT 92 NICKI WAY		
REVISIONS:	SCALE: 1"=20'	DATE: 5/17/12
	DRAWN BY: TRB	CHK'D BY: JRA
<i>25 Nicki Way</i>	JOB: 2004-439	FILE: PHASE5B.dwg

Andrews Survey & Engineering, Inc.
 Land Surveying - Civil Engineering - Site Planning

AST
 P.O. Box 312, 104 Mendon Street
 Uxbridge, Massachusetts 01569-0312
 P: 508-278-3897 F: 508-278-2289