



DECLARATION LEGEND

SUB-PHASE 4A
LCE 104 = 4,379 S.F.
COMMON ELEMENT = 43,166± S.F.

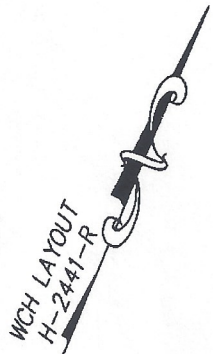

PLAN REFERENCE:
PLAN BOOK 857, PLAN 102

I CERTIFY THAT THIS PLAN SHOWS THE UNIT BEING CONVEYED AND OF IMMEDIATE ADJOINING UNITS, AND THAT IT FULLY AND ACCURATELY DEPICTS THE LAYOUT, LOCATION, DIMENSIONS, APPROXIMATE AREA, UNIT NUMBER, MAIN ENTRANCE, AND IMMEDIATE COMMON AREA TO WHICH IT HAS ACCESS, AS BUILT.

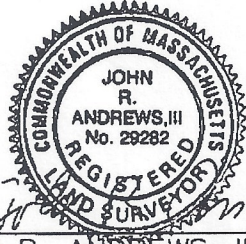

John R. Andrews, III 6/15/07
JOHN R. ANDREWS, III, P.L.S. DATE

**SUMMERFIELD AT TAFT HILL CONDOMINIUM - SUB-PHASE 4A
ANDREWS WAY, UXBRIDGE, MA**

FAIRWAY UNIT PLAN - UNIT 104 ANDREWS WAY			Andrews Survey & Engineering, Inc. Land Surveying Civil Engineering Site Planning P.O. Box 312, 104 Mendon Street Uxbridge, Massachusetts 01569-0312 P: 508-278-3897 F: 508-278-2289
REVISIONS:	SCALE: 1"=20'	DATE: 6-14-07	
	DRAWN BY: TRB	CHK'D BY: JRA	
<i>16 Andrews Drive</i>	JOB: 2004-439	FILE: phase4A	

ATTEST: WORC. Anthony J. Vigliotti, Register