



**DECLARATION LEGEND**

**SUB-PHASE 4C**  
 LCE 119 = 3,475 S.F.  
 COMMON ELEMENT = 72,732± S.F.

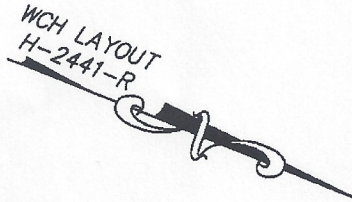

PLAN REFERENCE:  
 PLAN BOOK \_\_\_\_\_, PLAN \_\_\_\_\_

I CERTIFY THAT THIS PLAN SHOWS THE UNIT BEING CONVEYED AND OF IMMEDIATE ADJOINING UNITS, AND THAT IT FULLY AND ACCURATELY DEPICTS THE LAYOUT, LOCATION, DIMENSIONS, APPROXIMATE AREA, UNIT NUMBER, MAIN ENTRANCE, AND IMMEDIATE COMMON AREA TO WHICH IT HAS ACCESS, AS BUILT.

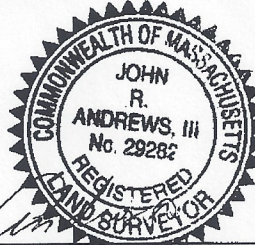

*John R. Andrews, III*  
 JOHN R. ANDREWS, III, P.L.S. DATE 3/21/08

SUB-PHASE 4C COMMON ELEMENT

**SUMMERFIELD AT TAFT HILL CONDOMINIUM - SUB-PHASE 4C  
 ANDREWS DRIVE, UXBRIDGE, MA**

**VILLAGE UNIT PLAN - UNIT 119 ANDREWS DRIVE**

Andrews Survey & Engineering, Inc.  
 Land Surveying Civil Engineering Site Planning

**ASE**

Post Box 228, 104 Mendon Street  
 Uxbridge, Massachusetts 01569-0312  
 P: 508-278-3897 F: 508-278-2289

REVISIONS:	SCALE: 1"=20'	DATE: 3-17-08
	DRAWN BY: TRB	CHK'D BY: JRA
39 Andrews	JOB: 2004-439	FILE: PHASE4C_REV

ATTEST: WORC. Anthony J. Vigliotti, Register