


**DECLARATION LEGEND**

**SUB-PHASE 5D**


LCE 84 = 7,386 S.F.

COMMON ELEMENT = 19,304± S.F.

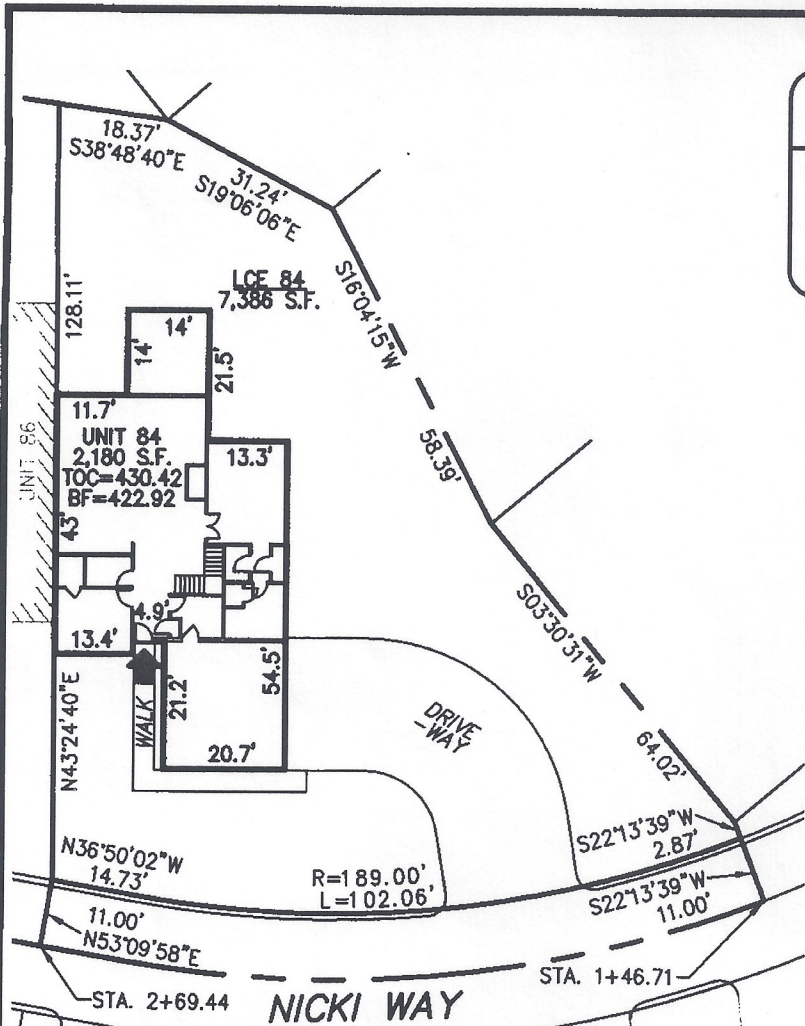

PLAN REFERENCE:  
PLAN BOOK , PLAN

I CERTIFY THAT THIS PLAN SHOWS THE UNIT BEING CONVEYED AND OF IMMEDIATE ADJOINING UNITS, AND THAT IT FULLY AND ACCURATELY DEPICTS THE LAYOUT, LOCATION, DIMENSIONS, APPROXIMATE AREA, UNIT NUMBER, MAIN ENTRANCE, AND IMMEDIATE COMMON AREA TO WHICH IT HAS ACCESS, AS BUILT.

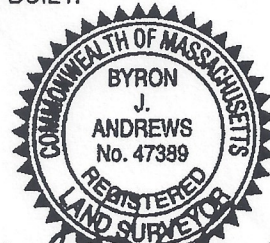

*Byron J. Andrews*  
4/16/14

**SUMMERFIELD AT TAFT HILL CONDOMINIUM - SUB-PHASE 5D  
NICKI WAY, UXBRIDGE, MA**

**VILLAGE UNIT PLAN - UNIT 84 NICKI WAY**

**Andrews Survey & Engineering, Inc.**  
Land Surveying, Civil Engineering, Site Planning

REVISIONS:	SCALE: 1"=30'	DATE: 4/15/14
	DRAWN BY: TRB	CHK'D BY: JRA
15 Nicki	JOB: 2004-439	FILE: PHASE5D_REV.dwg

P.O. Box 912, 104 Mendon Street  
Uxbridge, Massachusetts 01569-0312  
P: 508-278-3897 F: 508-278-2289

ATTEST: WORC. Anthony J. Vigliotti, Register