

DECLARATION LEGEND

SUB-PHASE 3B

LCE 35 = 3,705 S.F.


COMMON ELEMENT = 45,619± S.F.

WCH LAYOUT
H-2441-R




PLAN REFERENCE:
PLAN BOOK _____, PLAN _____

I CERTIFY THAT THIS PLAN SHOWS THE UNIT BEING CONVEYED AND OF IMMEDIATE ADJOINING UNITS, AND THAT IT FULLY AND ACCURATELY DEPICTS THE LAYOUT, LOCATION, DIMENSIONS, APPROXIMATE AREA, UNIT NUMBER, MAIN ENTRANCE, AND IMMEDIATE COMMON AREA TO WHICH IT HAS ACCESS, AS BUILT.

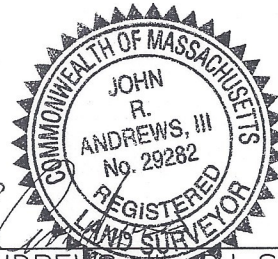

John R. Andrews, III
JOHN R. ANDREWS, III, P.L.S. 9/17/09
DATE

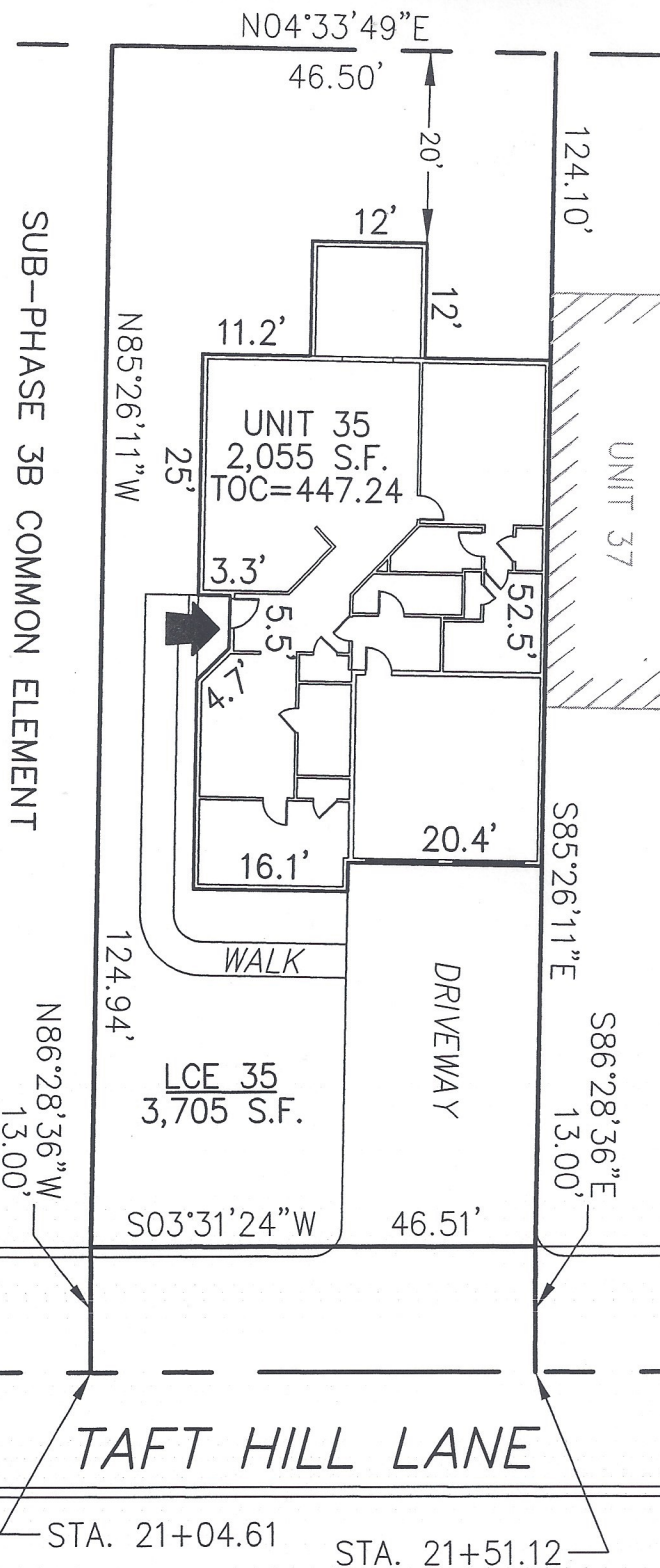

SUMMERFIELD AT TAFT HILL CONDOMINIUM - SUB-PHASE 3B TAFT HILL LANE, UXBRIDGE, MA

DOVER UNIT PLAN - UNIT 35 TAFT HILL LANE

REVISIONS:

SCALE: 1"=20'

DATE: 9-16-09

DRAWN BY: TRB

CHK'D BY: JRA

JOB: 2004-439

FILE: PHASE3B_revised

108 Taft Hill Lane

Andrews Survey & Engineering, Inc.
Land Surveying - Civil Engineering - Site Planning

ASTA
P.O. Box 312, 104 Mendon Street
Uxbridge, Massachusetts 01569-0312
P: 508-278-3897 F: 508-278-2289