



DECLARATION LEGEND

SUB-PHASE 5E
 LCE 85 = 4,269 S.F.
 COMMON ELEMENT = 91,180± S.F.

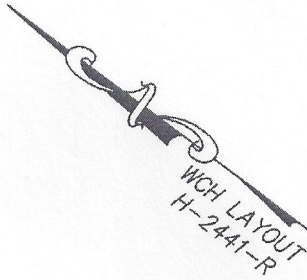

PLAN REFERENCE:
 PLAN BOOK , PLAN

I CERTIFY THAT THIS PLAN SHOWS THE UNIT BEING CONVEYED AND OF IMMEDIATE ADJOINING UNITS, AND THAT IT FULLY AND ACCURATELY DEPICTS THE LAYOUT, LOCATION, DIMENSIONS, APPROXIMATE AREA, UNIT NUMBER, MAIN ENTRANCE, AND IMMEDIATE COMMON AREA TO WHICH IT HAS ACCESS, AS BUILT.

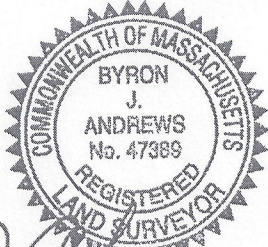

Byron J. Andrews 1/28/14

**SUMMERFIELD AT TAFT HILL CONDOMINIUM – SUB-PHASE 5E
 NICKI WAY, UXBRIDGE, MA**

FAIRWAY UNIT PLAN – UNIT 85 NICKI WAY		
REVISIONS:	SCALE: 1"=20'	DATE: 1/27/14
	DRAWN BY: TRB	CHK'D BY: BJA
16 Nicki	JOB: 2004-439	FILE: PHASE5E.dwg

Andrews Survey & Engineering, Inc.
 Land Surveying - Civil Engineering - Site Planning
 P.O. Box 312, 104 Mendon Street
 Uxbridge, Massachusetts 01569-0312
 P: 508-278-3897 F: 508-278-2289