



DECLARATION LEGEND

SUB-PHASE 1E
 LCE 47 = 4,391 S.F.
 COMMON ELEMENT = 41,894± S.F.

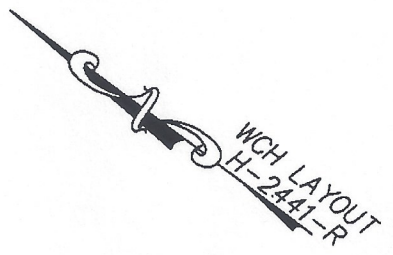

PLAN REFERENCE:
 PLAN BOOK , PLAN

I CERTIFY THAT THIS PLAN SHOWS THE UNIT BEING CONVEYED AND OF IMMEDIATE ADJOINING UNITS, AND THAT IT FULLY AND ACCURATELY DEPICTS THE LAYOUT, LOCATION, DIMENSIONS, APPROXIMATE AREA, UNIT NUMBER, MAIN ENTRANCE, AND IMMEDIATE COMMON AREA TO WHICH IT HAS ACCESS, AS BUILT.

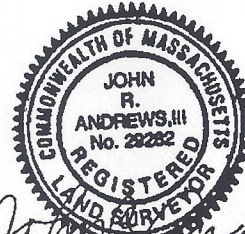

John R. Andrews, III
 JOHN R. ANDREWS, III, P.L.S. DATE

**SUMMERFIELD AT TAFT HILL CONDOMINIUM - SUB-PHASE 1E
 TAFT HILL LANE, UXBRIDGE, MA**

FAIRWAY UNIT PLAN - 47 TAFT HILL LANE

Andrews Survey & Engineering, Inc.
 Land Surveying, Civil Engineering, Site Planning

ASE
 P.O. Box 242, 104 Mendon Street
 Uxbridge, Massachusetts 01569-0312
 P: 508-278-3897 F: 508-278-2289

REVISIONS:	SCALE: 1"=20'	DATE: 10-27-06
	DRAWN BY: TRB	CHK'D BY: JRA
47 Taft Hill Lane	JOB: 2004-439	FILE: phase1E_rev(2)

ATTEST: WORC. Anthony J. Vigilanti, Register