



DECLARATION LEGEND

SUB-PHASE 4B
LCE 107 = 4,911 S.F.
COMMON ELEMENT = 232,645± S.F.

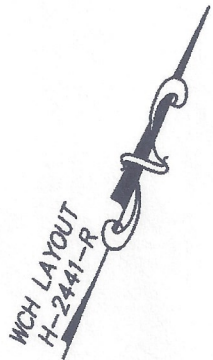

PLAN REFERENCE:
PLAN BOOK _____, PLAN _____

I CERTIFY THAT THIS PLAN SHOWS THE UNIT BEING CONVEYED AND OF IMMEDIATE ADJOINING UNITS, AND THAT IT FULLY AND ACCURATELY DEPICTS THE LAYOUT, LOCATION, DIMENSIONS, APPROXIMATE AREA, UNIT NUMBER, MAIN ENTRANCE, AND IMMEDIATE COMMON AREA TO WHICH IT HAS ACCESS, AS BUILT.

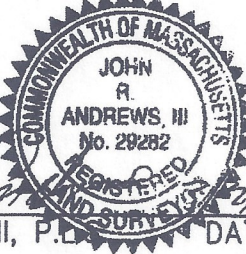John R. Andrews, III

 JOHN R. ANDREWS, III, P.L.S. DATE _____

**SUMMERFIELD AT TAFT HILL CONDOMINIUM - SUB-PHASE 4B
ANDREWS DRIVE, UXBRIDGE, MA**

FAIRWAY UNIT PLAN - UNIT 107 ANDREWS DRIVE		
REVISIONS:	SCALE: 1"=20'	DATE: 3-17-08
	DRAWN BY: TRB	CHK'D BY: JRA
19 Andrews Drive	JOB: 2004-439	FILE: PHASE4B_REV

Andrews Survey & Engineering, Inc.
 Land Surveying, Civil Engineering, Site Planning

ASE

Post Box 212, Red Mendon Street
 Uxbridge, Massachusetts 01569-0312
 P: 508-278-4407 F: 508-278-2720

ATTEST: WORC. Anthony J. Vigilotti, Register