



DECLARATION LEGEND

SUB-PHASE 4B
 LCE 108 = 4,211 S.F.
 COMMON ELEMENT = 246,102± S.F.

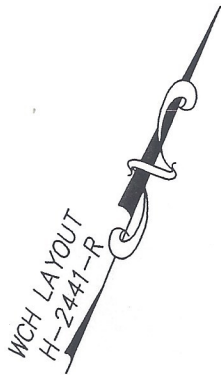

PLAN REFERENCE:
 PLAN BOOK _____, PLAN _____

I CERTIFY THAT THIS PLAN SHOWS THE UNIT BEING CONVEYED AND OF IMMEDIATE ADJOINING UNITS, AND THAT IT FULLY AND ACCURATELY DEPICTS THE LAYOUT, LOCATION, DIMENSIONS, APPROXIMATE AREA, UNIT NUMBER, MAIN ENTRANCE, AND IMMEDIATE COMMON AREA TO WHICH IT HAS ACCESS, AS BUILT.

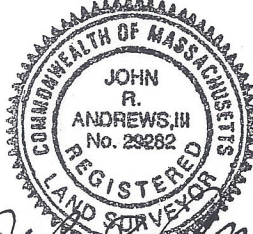

John R. Andrews 10/10/07
 JOHN R. ANDREWS, III, P.L.S. DATE

**SUMMERFIELD AT TAFT HILL CONDOMINIUM - SUB-PHASE 4B
 ANDREWS DRIVE, UXBRIDGE, MA**

FAIRWAY UNIT PLAN - UNIT 108 ANDREWS DRIVE

REVISIONS:	SCALE: 1"=20'	DATE: 10-5-07
	DRAWN BY: TRB	CHK'D BY: JRA
<i>21 Andrews</i>	JOB: 2004-439	FILE: PHASE4B

Andrews Survey & Engineering, Inc.
 Land Surveying Civil Engineering Site Planning
AS&E
 P.O. Box 342, 104 Mendon Street
 Uxbridge, Massachusetts 01569-0312
 P: 508-278-3897 F: 508-278-2289