



DECLARATION LEGEND

SUB-PHASE 2D
 LCE 3 = 4,078 S.F.
 COMMON ELEMENT = 73,009± S.F.

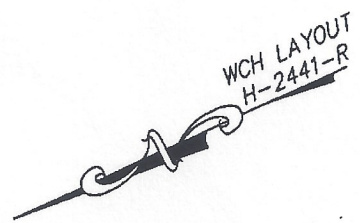

PLAN REFERENCE:
 PLAN BOOK , PLAN

I CERTIFY THAT THIS PLAN SHOWS THE UNIT BEING CONVEYED AND OF IMMEDIATE ADJOINING UNITS, AND THAT IT FULLY AND ACCURATELY DEPICTS THE LAYOUT, LOCATION, DIMENSIONS, APPROXIMATE AREA, UNIT NUMBER, MAIN ENTRANCE, AND IMMEDIATE COMMON AREA TO WHICH IT HAS ACCESS AS BUILT.

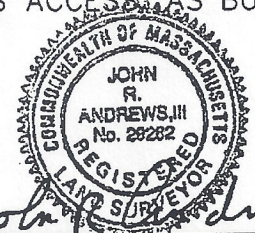

John R. Andrews, III
 JOHN R. ANDREWS, III, P.L.S. 1/24/07 DATE

**SUMMERFIELD AT TAFT HILL CONDOMINIUM - SUB-PHASE 2D
 SUMMERFIELD DRIVE, UXBRIDGE, MA**

DOVER UNIT PLAN - UNIT 3 SUMMERFIELD DR.

Andrews Survey & Engineering, Inc.
 Land Surveying Civil Engineering Site Planning
ASPE
 P.O. Box 212, 104 Mendon Street
 Uxbridge, Massachusetts 01569-0312
 P: 508-278-3897 F: 508-278-2289

| | | |
|-----------------------|---------------|-----------------------|
| REVISIONS: | SCALE: 1"=20' | 1/23/07 |
| | DRAWN BY: TRB | CHK'D BY: JRA |
| <i>11 Summerfield</i> | JOB: 2004-439 | FILE: phase2D_revised |

ATTEST: WORC. Anthony J. Vigliotti, Register