


DECLARATION LEGEND

SUB-PHASE 2E
 LCE 26 = 3,223 S.F.
 COMMON ELEMENT = 84,320± S.F.

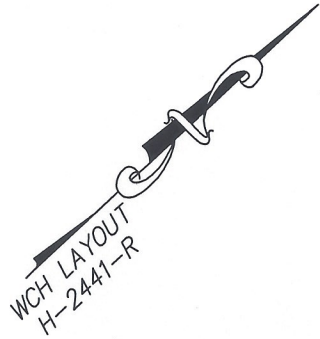

PLAN REFERENCE:
 PLAN BOOK _____, PLAN _____

I CERTIFY THAT THIS PLAN SHOWS THE UNIT BEING CONVEYED AND OF IMMEDIATE ADJOINING UNITS, AND THAT IT FULLY AND ACCURATELY DEPICTS THE LAYOUT, LOCATION, DIMENSIONS, APPROXIMATE AREA, UNIT NUMBER, MAIN ENTRANCE, AND IMMEDIATE COMMON AREA TO WHICH IT HAS ACCESS, AS BUILT.

SUB-PHASE 2E
 COMMON ELEMENT

JOHN R. ANDREWS, III, P.L.S. _____ DATE _____

**SUMMERFIELD AT TAFT HILL CONDOMINIUM – SUB-PHASE 2E
 SUMMERFIELD DRIVE, UXBRIDGE, MA**

COTTAGE UNIT PLAN – UNIT 26 SUMMERFIELD DR.

Andrews Survey & Engineering, Inc.
 Land Surveying - Civil Engineering - Site Planning

REVISIONS:	SCALE: 1' = 20'	DATE: 10/13/10
	DRAWN BY: TRB	CHK'D BY: JRA
<i>49 Summerfield</i>	JOB: 2004-439	FILE: PHASE 2E_rev(8)

ASPE
 P.O. Box 312, 104 Mendon Street
 Uxbridge, Massachusetts 01569-0312
 P: 508-278-3897 F: 508-278-2289