

STA 5+59.71
- STA 5+15.71

SUMMERFIELD DR.

N39°00'30"E
11.00' 11.00'
S39°00'30"W

44.00'
S50°59'30"E

DRIVEWAY

N38°27'44"E

WALK

20.7'

21.2'

4.9'

13.4'

2.1'

4.3'

UNIT 14

1,972 S.F.

SLAB=449.26

25.7'

7.5'

54.5'

13.3'

123.50'

LCE 14
5,425 S.F.

44.00'

N51°32'16"W

S38°27'44"W

SUB-PHASE 2E COMMON ELEMENT


SUB-PHASE 2E COMMON ELEMENT

DECLARATION LEGEND

SUB-PHASE 2E

LCE 14 = 5,425 S.F.

COMMON ELEMENT = 106,135± S.F.

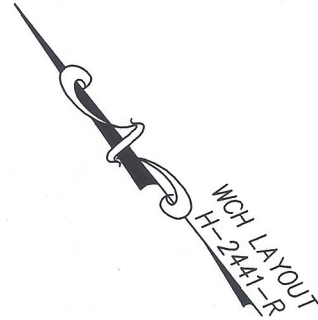

PLAN REFERENCE:
PLAN BOOK , PLAN

I CERTIFY THAT THIS PLAN SHOWS THE UNIT BEING CONVEYED AND OF IMMEDIATE ADJOINING UNITS, AND THAT IT FULLY AND ACCURATELY DEPICTS THE LAYOUT, LOCATION, DIMENSIONS, APPROXIMATE AREA, UNIT NUMBER, MAIN ENTRANCE, AND IMMEDIATE COMMON AREA TO WHICH IT HAS ACCESS, AS BUILT.

JOHN R. ANDREWS, III, P.L.S.

DATE

SUMMERFIELD AT TAFT HILL CONDOMINIUM - SUB-PHASE 2E SUMMERFIELD DRIVE, UXBRIDGE, MA

VILLAGE UNIT PLAN - UNIT 14 SUMMERFIELD DR.

Andrews Survey & Engineering, Inc.
Land Surveying - Civil Engineering - Site Planning

REVISIONS:

SCALE: 1"=20'

DATE: 6/23/09

DRAWN BY: TRB

CHK'D BY: JRA

29 Summerfield

JOB: 2004-439

FILE: PHASE 2E_rev(6)

P.O. Box 312, 104 Mendon Street
Uxbridge, Massachusetts 01569-0312
P: 508-278-3897 F: 508-278-2289