

**DECLARATION LEGEND**

**SUB-PHASE 4E**


LCE 126 = 3,732 S.F.

COMMON ELEMENT = 67,289± S.F.




PLAN REFERENCE:  
PLAN BOOK \_\_\_\_\_, PLAN \_\_\_\_\_

I CERTIFY THAT THIS PLAN SHOWS THE UNIT BEING CONVEYED AND OF IMMEDIATE ADJOINING UNITS, AND THAT IT FULLY AND ACCURATELY DEPICTS THE LAYOUT, LOCATION, DIMENSIONS, APPROXIMATE AREA, UNIT NUMBER, MAIN ENTRANCE, AND IMMEDIATE COMMON AREA TO WHICH IT HAS ACCESS, AS BUILT.

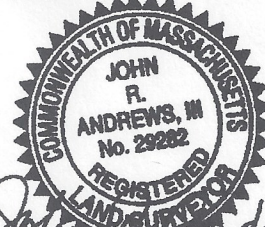

*John R. Andrews, M.*  
9/10/12

**ANDREWS DRIVE**

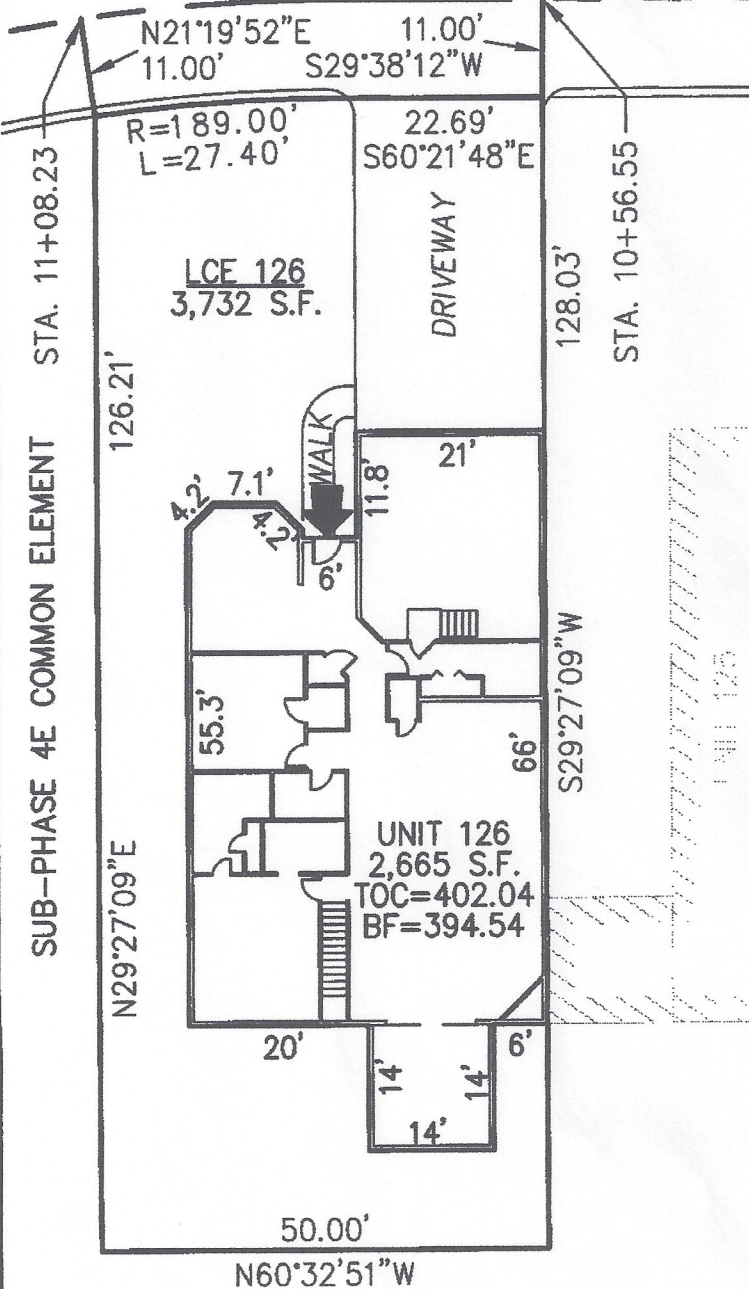

SUB-PHASE 4E COMMON ELEMENT

SUB-PHASE 4E COMMON ELEMENT

**SUMMERFIELD AT TAFT HILL CONDOMINIUM - SUB-PHASE 4E  
ANDREWS DRIVE, UXBRIDGE, MA**

**FAIRWAY UNIT PLAN - UNIT 126 ANDREWS DRIVE**

**Andrews Survey & Engineering, Inc.**  
Land Surveying Civil Engineering Site Planning

REVISIONS:	SCALE: 1"=20'	DATE: 9/7/12
	DRAWN BY: TRB	CHK'D BY: JRA
56 Andrews Drive	JOB: 2004-439	FILE: PHASE4E

**ASE**  
P.O. Box 342, 101 Mendon Street  
Uxbridge, Massachusetts 01569-0312  
P: 508-278-3897 F: 508-278-2289