



DECLARATION LEGEND

SUB-PHASE 2A
 LCE 4 = 4,415 S.F.
 COMMON ELEMENT = 62,825± S.F.

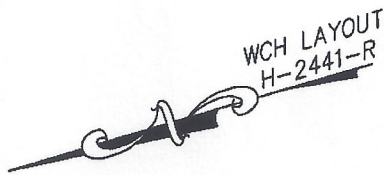

PLAN REFERENCE:
 PLAN BOOK , PLAN

I CERTIFY THAT THIS PLAN SHOWS THE UNIT BEING CONVEYED AND OF IMMEDIATE ADJOINING UNITS, AND THAT IT FULLY AND ACCURATELY DEPICTS THE LAYOUT, LOCATION, DIMENSIONS, APPROXIMATE AREA, UNIT NUMBER, MAIN ENTRANCE, AND IMMEDIATE COMMON AREA TO WHICH IT HAS ACCESS, AS BUILT.

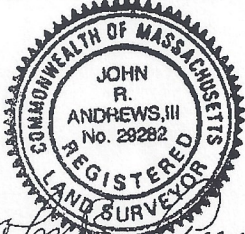

John R. Andrews, III 10/18/06
 JOHN R. ANDREWS, III, P.L.S. DATE

SUMMERFIELD AT TAFT HILL CONDOMINIUM - SUB-PHASE 2A
SUMMERFIELD DRIVE, UXBRIDGE, MA

DOVER UNIT PLAN - UNIT 4 SUMMERFIELD DR.

REVISIONS:	SCALE: 1"=20'	DATE: 10-18-06
	DRAWN BY: TRB	CHK'D BY: JRA
12 Summerfield	JOB: 2004-439	FILE: phase2A-REV

Andrews Survey & Engineering, Inc.
 Land Surveying, Civil Engineering, Site Planning

ASE
 P.O. Box 112, 101 Mendon Street
 Uxbridge, Massachusetts 01569-0312
 P: 508-278-3897 F: 508-278-2289

ATTEST: WORC. Anthony J. Vigliotti, Register