

DECLARATION LEGEND

SUB-PHASE 3B


LCE 41 = 3,378 S.F.

COMMON ELEMENT = 45,250± S.F.


WCH LAYOUT
H-2441-R

PLAN REFERENCE:
PLAN BOOK , PLAN

I CERTIFY THAT THIS PLAN SHOWS THE UNIT BEING CONVEYED AND OF IMMEDIATE ADJOINING UNITS, AND THAT IT FULLY AND ACCURATELY DEPICTS THE LAYOUT, LOCATION, DIMENSIONS, APPROXIMATE AREA, UNIT NUMBER, MAIN ENTRANCE, AND IMMEDIATE COMMON AREA TO WHICH IT HAS ACCESS, AS BUILT.

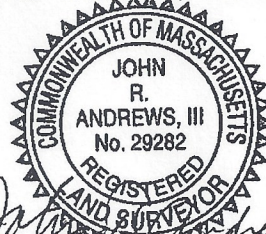

John R. Andrews, III 3-4-10
JOHN R. ANDREWS, III, P.L.S. DATE

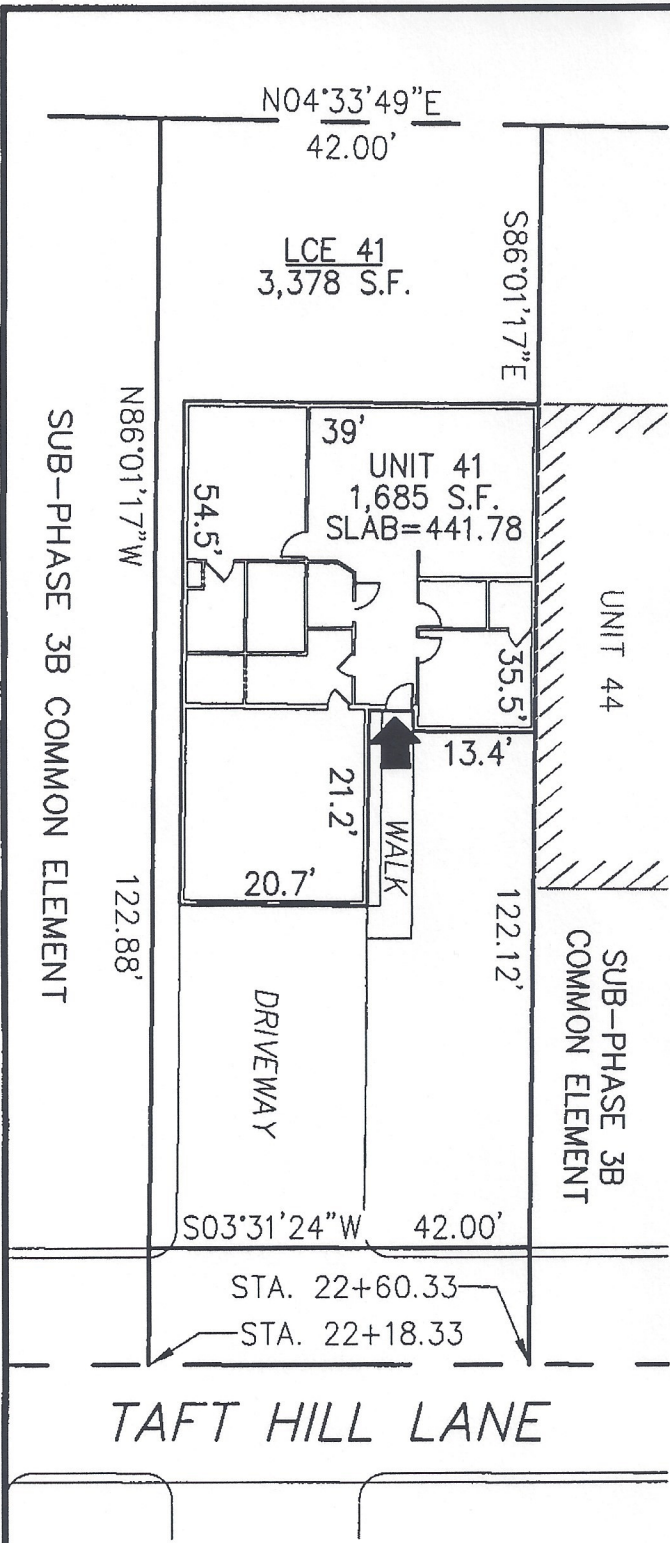

**SUMMERFIELD AT TAFT HILL CONDOMINIUM - SUB-PHASE 3B
TAFT HILL LANE, UXBRIDGE, MA**

COTTAGE UNIT PLAN - UNIT 41 TAFT HILL LANE

Andrews Survey & Engineering, Inc.
 Land Surveying Civil Engineering Site Planning
 P.O. Box 312, 104 Mendon Street
 Uxbridge, Massachusetts 01569-0312
 P: 508-278-3897 F: 508-278-2289

REVISIONS:	SCALE: 1"=20'	DATE: 3/4/10
	DRAWN BY: TRB	CHK'D BY: JRA
112 Taft Hill Lane	JOB: 2004-439	FILE: PHASE 3B_rev(2)