



DECLARATION LEGEND

SUB-PHASE 5F
 LCE 98 = 3,645 S.F.
 COMMON ELEMENT = 15,284± S.F.

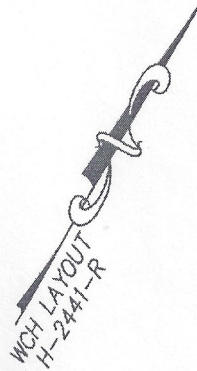

PLAN REFERENCE:
 PLAN BOOK , PLAN

I CERTIFY THAT THIS PLAN SHOWS THE UNIT BEING CONVEYED AND OF IMMEDIATE ADJOINING UNITS, AND THAT IT FULLY AND ACCURATELY DEPICTS THE LAYOUT, LOCATION, DIMENSIONS, APPROXIMATE AREA, UNIT NUMBER, MAIN ENTRANCE, AND IMMEDIATE COMMON AREA TO WHICH IT HAS ACCESS, AS BUILT.

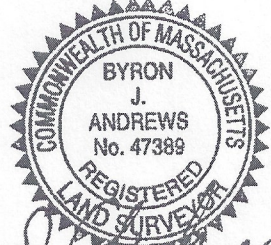

Byron J. Andrews 4/14/15

SUB-PHASE 5F COMMON ELEMENT
SUMMERFIELD AT TAFT HILL CONDOMINIUM - SUB-PHASE 5F
NICKI WAY, UXBRIDGE, MA

DOVER UNIT PLAN - UNIT 98 NICKI WAY

REVISIONS:	SCALE: 1"=20'	DATE: 4/14/15
	DRAWN BY: TRB	CHK'D BY: BJA
39 Nicki	JOB: 2004-439	FILE: PHASE5F.dwg

Andrews Survey & Engineering, Inc.
 Land Surveying - Civil Engineering - Site Planning
 P.O. Box 312, 104 Mendon Street
 Uxbridge, Massachusetts 01569-0312
 P: 508-278-3897 F: 508-278-2289