



**DECLARATION LEGEND**

SUB-PHASE 5D  
 LCE 86 = 3,790 S.F.  
 COMMON ELEMENT = 7,590± S.F.

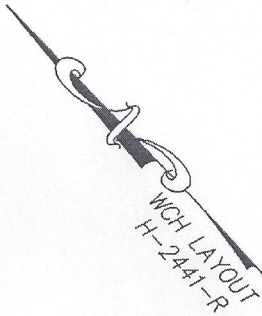

PLAN REFERENCE:  
 PLAN BOOK , PLAN

I CERTIFY THAT THIS PLAN SHOWS THE UNIT BEING CONVEYED AND OF IMMEDIATE ADJOINING UNITS, AND THAT IT FULLY AND ACCURATELY DEPICTS THE LAYOUT, LOCATION, DIMENSIONS, APPROXIMATE AREA, UNIT NUMBER, MAIN ENTRANCE, AND IMMEDIATE COMMON AREA TO WHICH IT HAS ACCESS, AS BUILT.

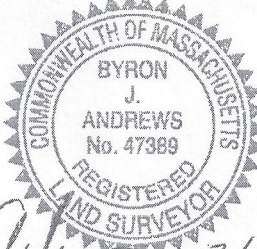

*Byron J. Andrews* 7/21/15

**SUMMERFIELD AT TAFT HILL CONDOMINIUM - SUB-PHASE 5D  
 NICKI WAY, UXBRIDGE, MA**

<b>DOVER UNIT PLAN - UNIT 86 NICKI WAY</b>		
REVISIONS:	SCALE: 1"=20'	DATE: 7/30/14
	DRAWN BY: TRB	CHK'D BY: JRA
<b>17 Nicki</b>	JOB: 2004-439	FILE: PHASE3D&5D.dwg

**Andrews Survey & Engineering, Inc.**  
 Land Surveying - Civil Engineering - Site Planning

P.O. Box 312, 104 Mendon Street  
 Uxbridge, Massachusetts 01569-0312  
 P: 508-278-3897 F: 508-278-2289