



DECLARATION LEGEND

SUB-PHASE 5E
 LCE 83 = 5,294 S.F.
 COMMON ELEMENT = 83,757± S.F.

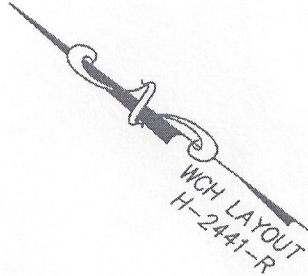

PLAN REFERENCE:
 PLAN BOOK , PLAN

I CERTIFY THAT THIS PLAN SHOWS THE UNIT BEING CONVEYED AND OF IMMEDIATE ADJOINING UNITS, AND THAT IT FULLY AND ACCURATELY DEPICTS THE LAYOUT, LOCATION, DIMENSIONS, APPROXIMATE AREA, UNIT NUMBER, MAIN ENTRANCE, AND IMMEDIATE COMMON AREA TO WHICH IT HAS ACCESS, AS BUILT.

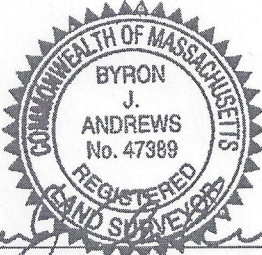

Byron J. Andrews
 4/16/14

**SUMMERFIELD AT TAFT HILL CONDOMINIUM - SUB-PHASE 5E
 NICKI WAY, UXBRIDGE, MA**

DOVER UNIT PLAN - UNIT 83 NICKI WAY

Andrews Survey & Engineering, Inc.
 Land Surveying - Civil Engineering - Site Planning
 P.O. Box 312, 104 Mendon Street
 Uxbridge, Massachusetts 01569-0312
 P: 508-278-3897 F: 508-278-2289

REVISIONS:	SCALE: 1"=20'	DATE: 4/8/14
	DRAWN BY: TRB	CHK'D BY: BJA
14 Nicki	JOB: 2004-439	FILE: PHASE5E_REV.dwg