


SUB-PHASE 1C COMMON ELEMENT

DECLARATION LEGEND

SUB-PHASE 1C


LCE 82 = 4,988 S.F

COMMON ELEMENT = 47,608± S.F.

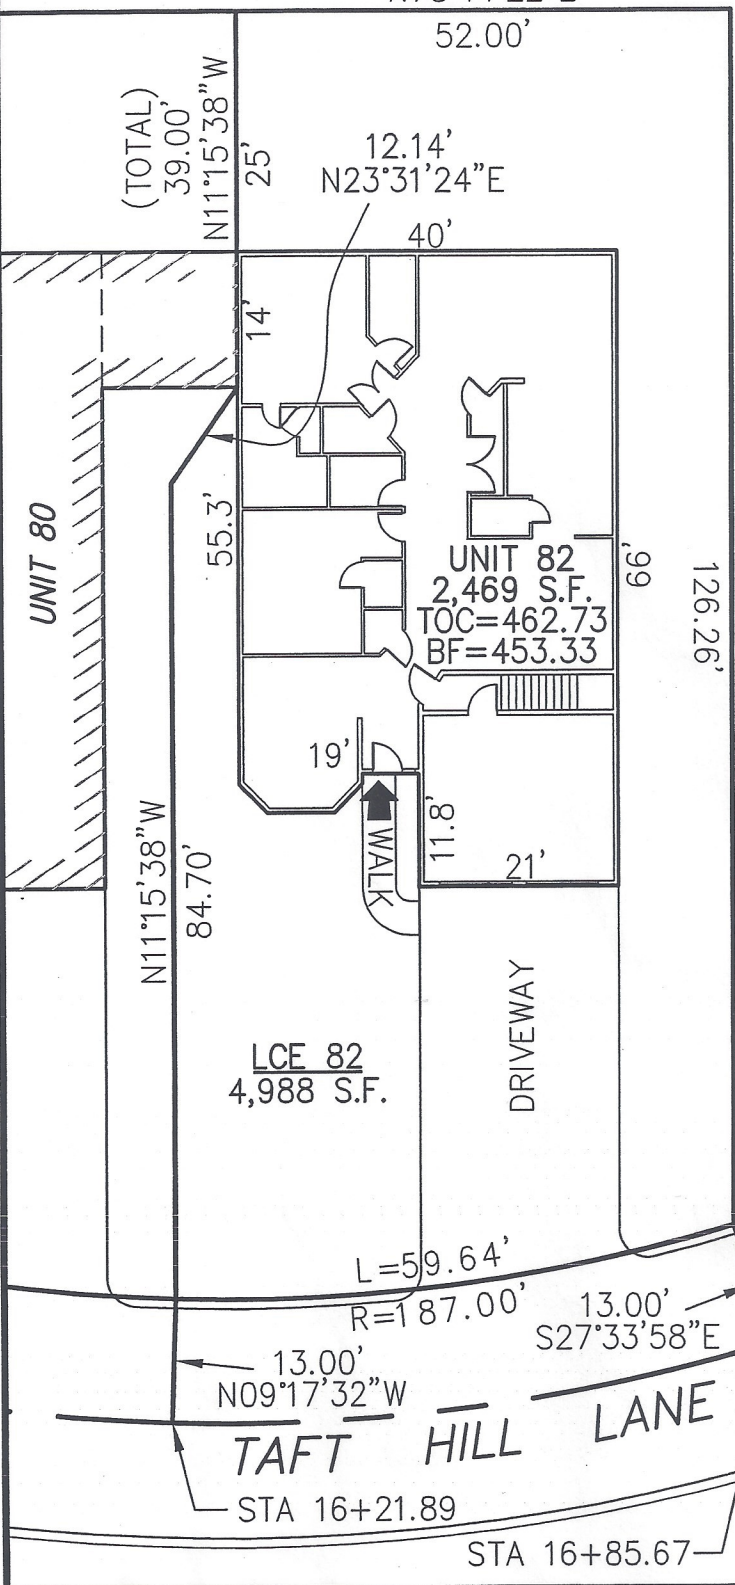

PLAN REFERENCE:  
PLAN BOOK , PLAN

I CERTIFY THAT THIS PLAN SHOWS THE UNIT BEING CONVEYED AND OF IMMEDIATE ADJOINING UNITS, AND THAT IT FULLY AND ACCURATELY DEPICTS THE LAYOUT, LOCATION, DIMENSIONS, APPROXIMATE AREA, UNIT NUMBER, MAIN ENTRANCE, AND IMMEDIATE COMMON AREA TO WHICH IT HAS ACCESS, AS BUILT.

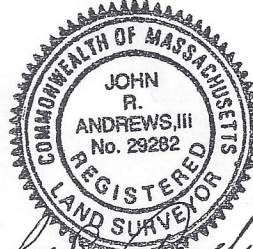

*John R. Andrews*  
JOHN R. ANDREWS, III, P.L.S. DATE 4/5/06

SUMMERFIELD AT TAFT HILL CONDOMINIUM - SUB-PHASE 1C  
TAFT HILL LANE, UXBRIDGE, MA

FAIRWAY UNIT PLAN - 82 TAFT HILL LANE

Andrews Survey & Engineering, Inc.  
Land Surveying Civil Engineering Site Planning

REVISIONS:	SCALE: 1"=20'	DATE: 1-9-06
1. 2/14/06 - ADDED INTERIOR WALLS	DRAWN BY: SJO	CHK'D BY: JRA
82 Taft Hill Lane	JOB: 2004-439	FILE: phase1C

P.O. Box 412, 104 Mendon Street  
Uxbridge, Massachusetts 01569-0312  
P: 508-278-3897 F: 508-278-2789