



DECLARATION LEGEND

SUB-PHASE 2A
 LCE 11 = 3,641 S.F.
 COMMON ELEMENT = 77,172± S.F.

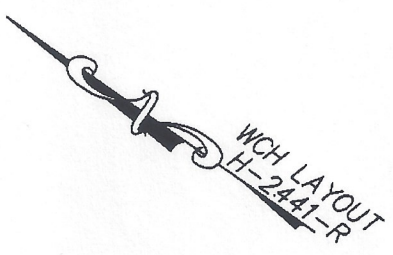

PLAN REFERENCE:
 PLAN BOOK , PLAN
 843 - 12

I CERTIFY THAT THIS PLAN SHOWS THE UNIT BEING CONVEYED AND OF IMMEDIATE ADJOINING UNITS, AND THAT IT FULLY AND ACCURATELY DEPICTS THE LAYOUT, LOCATION, DIMENSIONS, APPROXIMATE AREA, UNIT NUMBER, MAIN ENTRANCE, AND IMMEDIATE COMMON AREA TO WHICH IT HAS ACCESS, AS BUILT.

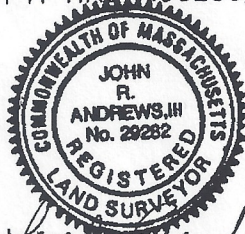

John R. Andrews, III 5/24/06
 JOHN R. ANDREWS, III, P.L.S. DATE

ATTEST: WORC. Anthony J. Vignotti, Registrar

**SUMMERFIELD AT TAFT HILL CONDOMINIUM - SUB-PHASE 2A
 SUMMERFIELD DRIVE, UXBRIDGE, MA**

VILLAGE UNIT PLAN - UNIT 11 SUMMERFIELD DR.

REVISIONS:	SCALE: 1'=20'	DATE: 5-22-06
	DRAWN BY: SJO	CHK'D BY: JRA
24 Summerfield	JOB: 2004-439	FILE: phase2A

Andrews Survey & Engineering, Inc.
 Land Surveyors Civil Engineers Site Planning
ASE
 P.O. Box 222, 104 Mendon Street
 Uxbridge, Massachusetts 01569-0312
 P: 508-278-3897 F: 508-278-2289