



**DECLARATION LEGEND**  
**PHASE 1A**  
 LCE 52 = 3,119 S.F.  
 COMMON ELEMENT = 348,001± S.F.

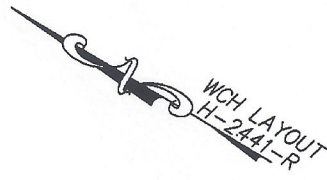

PLAN REFERENCE:  
 PLAN BOOK 934, PLAN 95

I CERTIFY THAT THIS PLAN SHOWS THE UNIT BEING CONVEYED AND OF IMMEDIATE ADJOINING UNITS, AND THAT IT FULLY AND ACCURATELY DEPICTS THE LAYOUT, LOCATION, DIMENSIONS, APPROXIMATE AREA, UNIT NUMBER, MAIN ENTRANCE, AND IMMEDIATE COMMON AREA TO WHICH IT HAS ACCESS, AS BUILT.

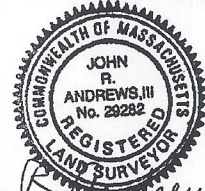

*John R. Andrews, III* 11/18/05  
 JOHN R. ANDREWS, III, P.L.S. DATE

**SUMMERFIELD AT TAFT HILL CONDOMINIUM - PHASE 1A  
 DOUGLAS STREET, UXBRIDGE, MA**

**DOVER UNIT PLAN - 52 TAFT HILL LANE**

REVISIONS:	SCALE: 1"=20'	DATE: 10-13-05
	DRAWN BY: SJO	CHK'D BY: JRA
<i>52 Taft Hill Lane</i>	JOB: 2004-439	FILE: phase1A

**Andrews Survey & Engineering, Inc.**  
 Land Surveying, Civil Engineering, Site Planning

**ASE**  
 P.O. Box 222, 101 Mendon Street  
 Uxbridge, Massachusetts 01569-0312  
 P: 508-278-3897 F: 508-278-2289

ATTEST: WORC. ANTHONY J. VIGNOLI, Register