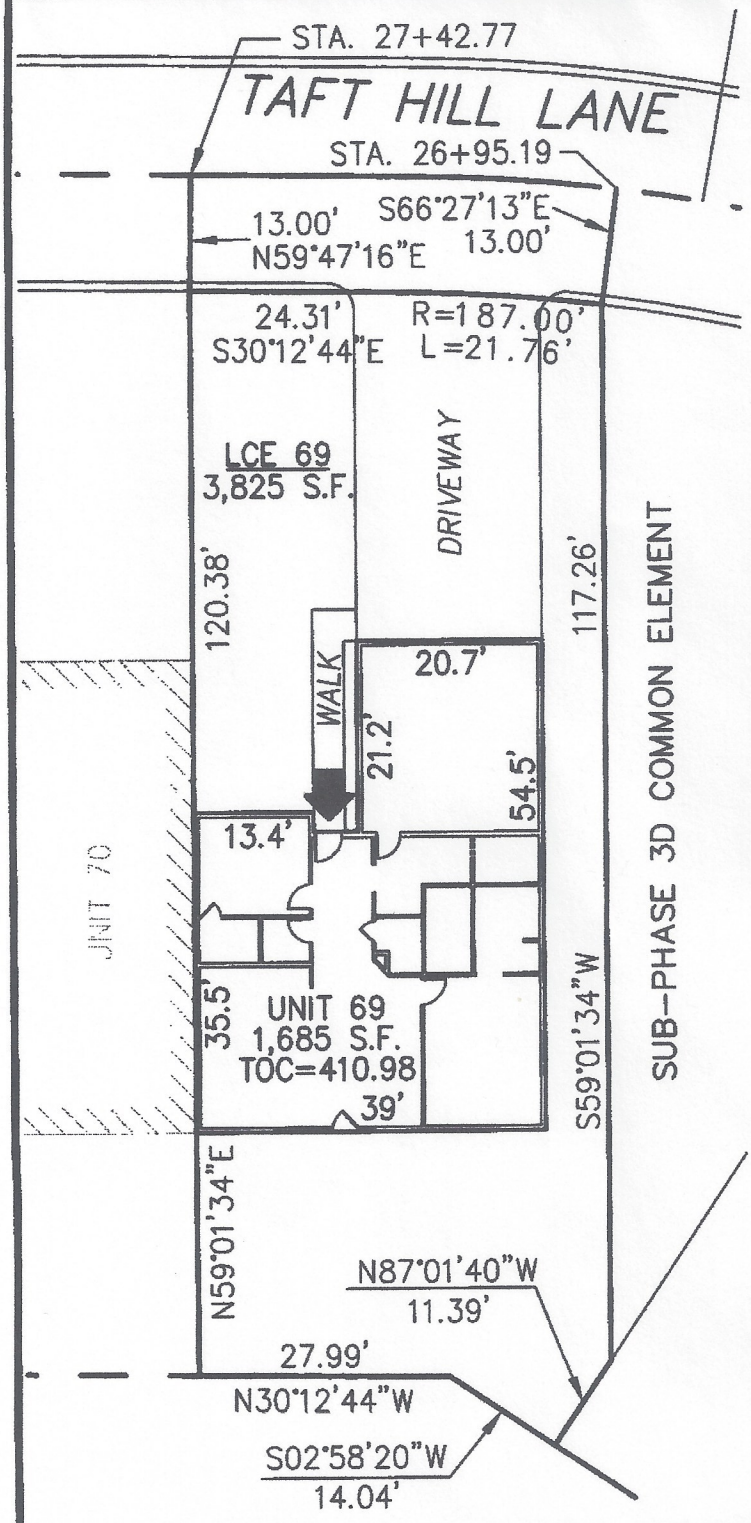

DECLARATION LEGEND

SUB-PHASE 3D
LCE 69 = 3,825 S.F.
COMMON ELEMENT = 18,707± S.F.

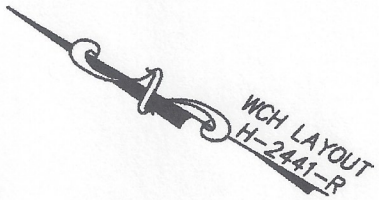

PLAN REFERENCE:
PLAN BOOK , PLAN

I CERTIFY THAT THIS PLAN SHOWS THE UNIT BEING CONVEYED AND OF IMMEDIATE ADJOINING UNITS, AND THAT IT FULLY AND ACCURATELY DEPICTS THE LAYOUT, LOCATION, DIMENSIONS, APPROXIMATE AREA, UNIT NUMBER, MAIN ENTRANCE, AND IMMEDIATE COMMON AREA TO WHICH IT HAS ACCESS, AS BUILT.

COMMONWEALTH OF MASSACHUSETTS
JOHN R. ANDREWS, III
No. 29282
REGISTERED LAND SURVEYOR

John R. Andrews III
9/10/12

SUMMERFIELD AT TAFT HILL CONDOMINIUM – SUB-PHASE 3D
TAFT HILL LANE, UXBRIDGE, MA

COTTAGE UNIT PLAN – UNIT 69 TAFT HILL LANE

REVISIONS:	SCALE: 1'=20'	DATE: 9/7/12
	DRAWN BY: TRB	CHK'D BY: JRA
138 Taft Hill Lane	JOB: 2004-439	FILE: PHASE3D_REV

Andrews Survey & Engineering, Inc.
Land Surveying · Civil Engineering · Site Planning
P.O. Box 312, 184 Mendon Street
Uxbridge, Massachusetts 01569-0312
P: 508-278-3897 F: 508-278-2289

ATTEST: WORC. Anthony J. Vigliotti, Register