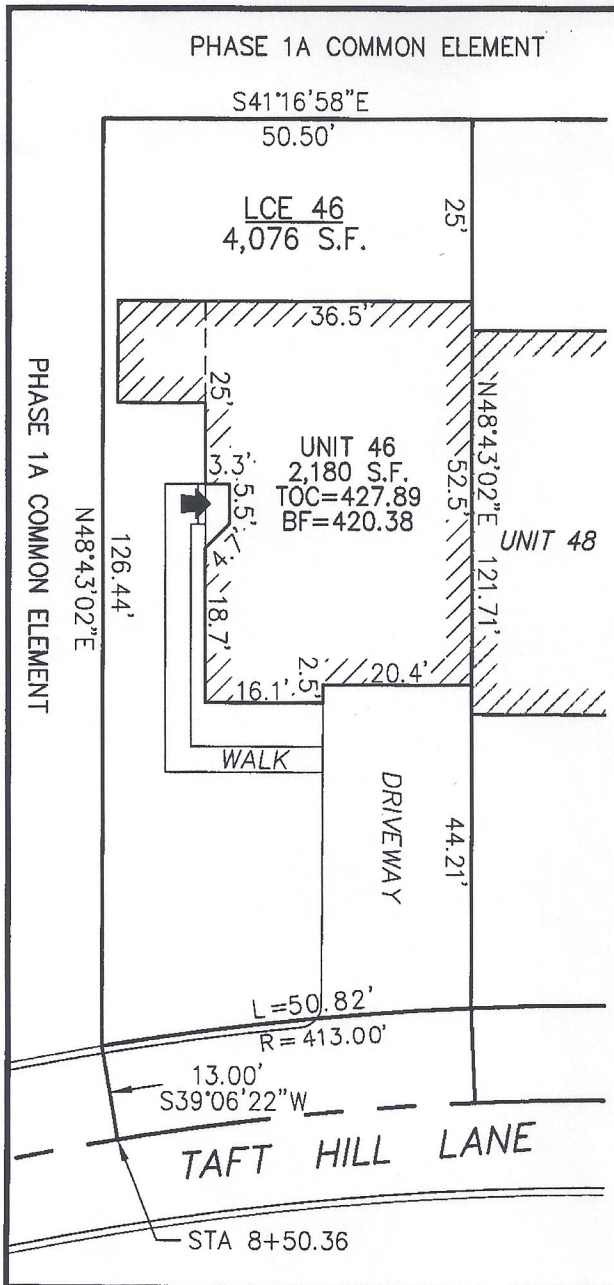

DECLARATION LEGEND

PHASE 1A

LCE 46 = 4,076 S.F

COMMON ELEMENT = 348,001± S.F.

PLAN REFERENCE:
PLAN BOOK 834, PLAN 95

I CERTIFY THAT THIS PLAN SHOWS THE UNIT BEING CONVEYED AND OF IMMEDIATE ADJOINING UNITS, AND THAT IT FULLY AND ACCURATELY DEPICTS THE LAYOUT, LOCATION, DIMENSIONS, APPROXIMATE AREA, UNIT NUMBER, MAIN ENTRANCE, AND IMMEDIATE COMMON AREA TO WHICH IT HAS ACCESS, AS BUILT.

COMMONWEALTH OF MASSACHUSETTS
JOHN R. ANDREWS, III
No. 28282
REGISTERED PROFESSIONAL LAND SURVEYOR

John R. Andrews III 11/18/05

JOHN R. ANDREWS, P.L.S. DATE

SUMMERFIELD AT TAFT HILL CONDOMINIUM – PHASE 1A
DOUGLAS STREET, UXBRIDGE, MA

DOVER UNIT PLAN – 46 TAFT HILL LANE

REVISIONS:	SCALE: 1'=20'	DATE: 10-13-05
	DRAWN BY: SJO	CHK'D BY: JRA
46 Taft Hill Lane	JOB: 2004-439	FILE: phase1A

Andrews Survey & Engineering, Inc.
Land Surveying | Civil Engineering | Site Planning
P.O. Box 312, 104 Mendon Street
Uxbridge, Massachusetts 01569-0312
P: 508-278-3897 F: 508-278-2289

ATTEST: WORC. Anthony J. Vigliotti, Register