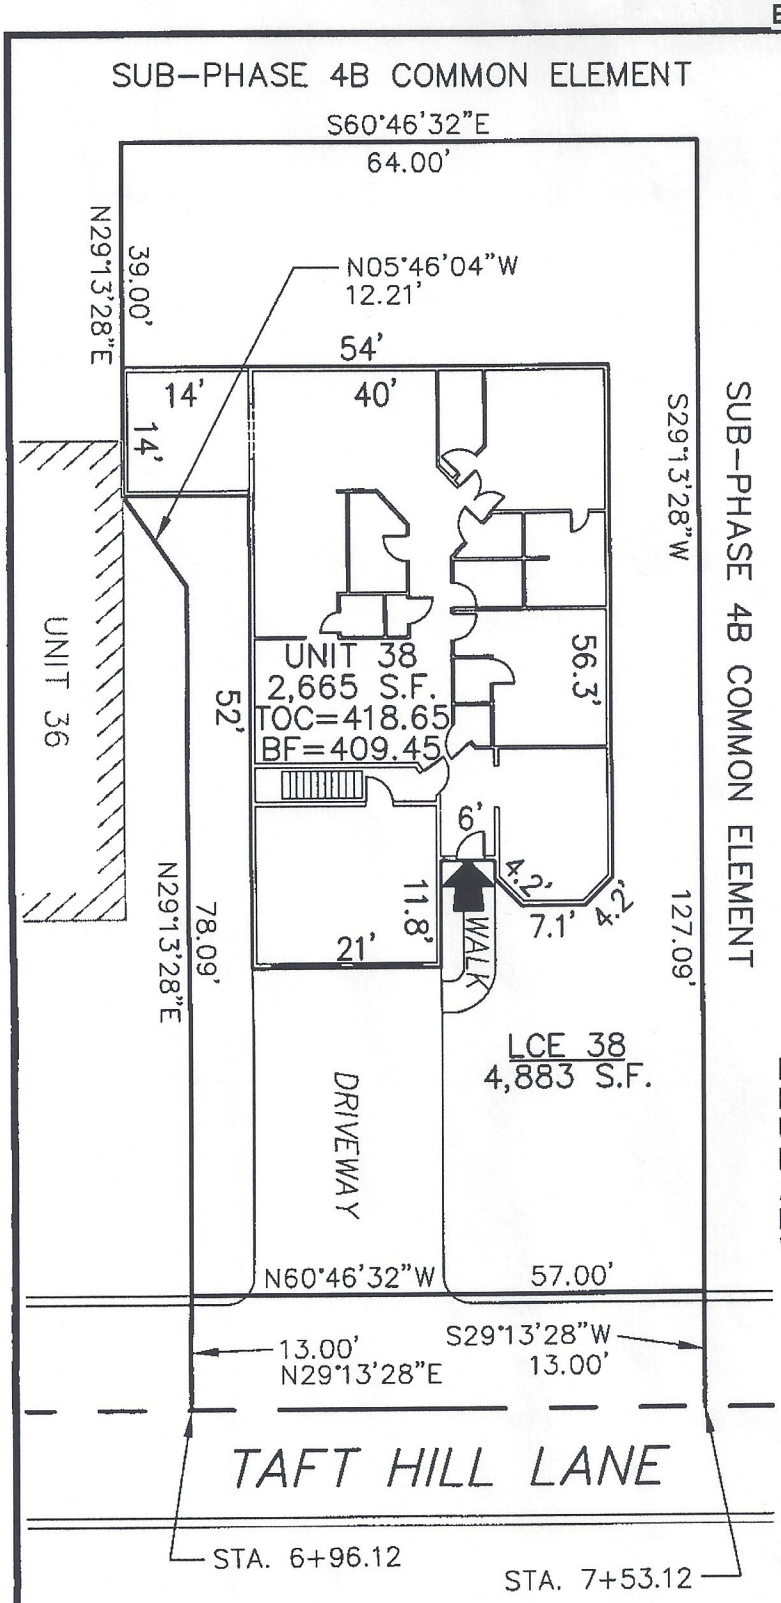

DECLARATION LEGEND

SUB-PHASE 1A
LCE 38 = 4,883 S.F
COMMON ELEMENT = 328,396± S.F.

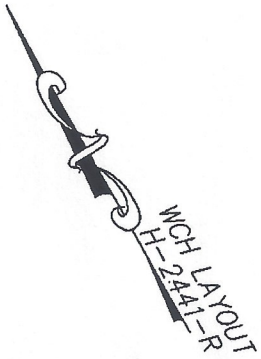

PLAN REFERENCE:
PLAN BOOK , PLAN

I CERTIFY THAT THIS PLAN SHOWS THE UNIT BEING CONVEYED AND OF IMMEDIATE ADJOINING UNITS, AND THAT IT FULLY AND ACCURATELY DEPICTS THE LAYOUT, LOCATION, DIMENSIONS, APPROXIMATE AREA, UNIT NUMBER, MAIN ENTRANCE, AND IMMEDIATE COMMON AREA TO WHICH IT HAS ACCESS, AS BUILT.

COMMONWEALTH OF MASSACHUSETTS
JOHN R. ANDREWS, III
No. 29282
REGISTERED LAND SURVEYOR

John R. Andrews III 5/27/11
JOHN R. ANDREWS, III, P.L.S. DATE

SUMMERFIELD AT TAFT HILL CONDOMINIUM – SUB-PHASE 1A
DOUGLAS STREET, UXBRIDGE, MA

FAIRWAY UNIT PLAN – 38 TAFT HILL LANE

REVISIONS:	SCALE: 1'=20'	DATE: 5/27/11
	DRAWN BY: TRB	CHK'D BY: JRA
38 Taft Hill Lane	JOB: 2004-439	FILE: PHASE 1A_rev(2)

Andrews Survey & Engineering, Inc.
Land Surveying - Civil Engineering - Site Planning
P.O. Box 312, 104 Mendon Street
Uxbridge, Massachusetts 01569-0312
P: 508-278-3897 F: 508-278-2289