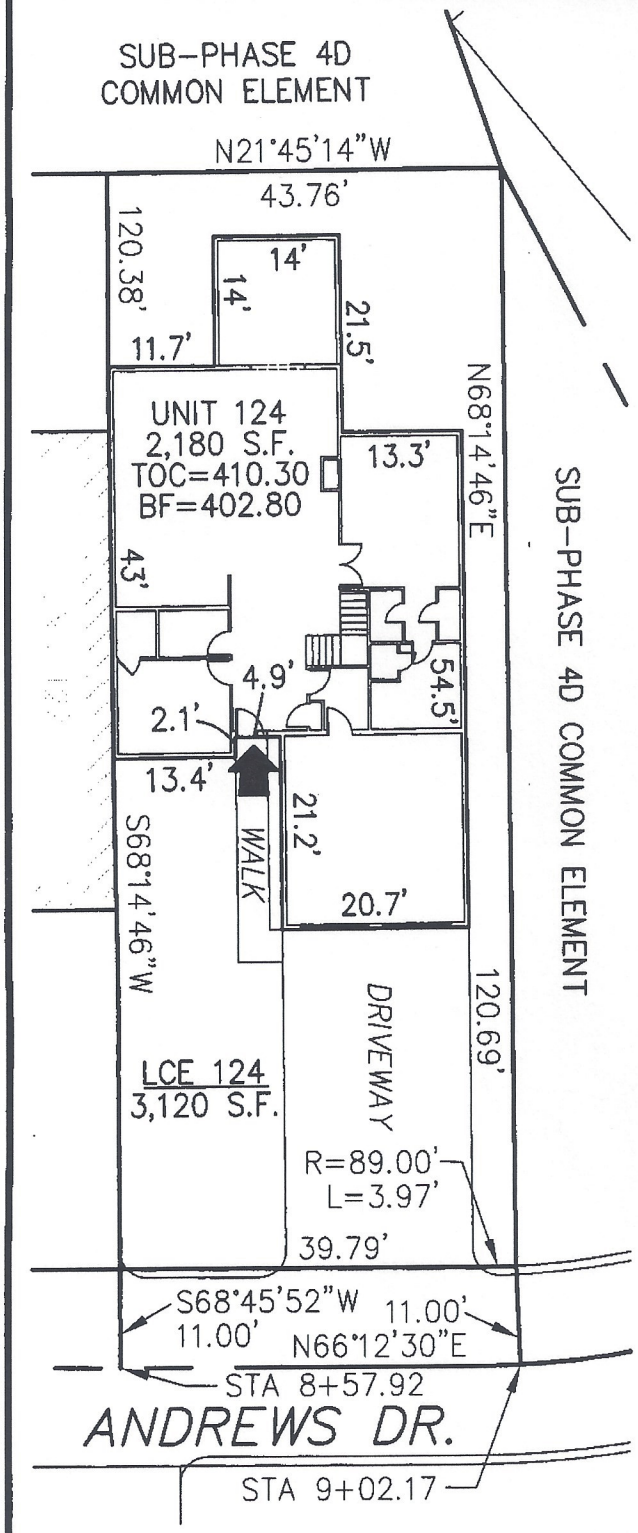

DECLARATION LEGEND

SUB-PHASE 4D

LCE 124 = 3,120 S.F.

COMMON ELEMENT = 60,070± S.F.

WCH LAYOUT
H-2441-R

PLAN REFERENCE:
PLAN BOOK , PLAN

I CERTIFY THAT THIS PLAN SHOWS THE UNIT BEING CONVEYED AND OF IMMEDIATE ADJOINING UNITS, AND THAT IT FULLY AND ACCURATELY DEPICTS THE LAYOUT, LOCATION, DIMENSIONS, APPROXIMATE AREA, UNIT NUMBER, MAIN ENTRANCE, AND IMMEDIATE COMMON AREA TO WHICH IT HAS ACCESS, AS BUILT.

COMMONWEALTH OF MASSACHUSETTS
JOHN R. ANDREWS, III
No. 29282
REGISTERED LAND SURVEYOR

John R. Andrews III
9/24/13

SUMMERFIELD AT TAFT HILL CONDOMINIUM – SUB-PHASE 4D
ANDREWS DRIVE, UXBRIDGE, MA

VILLAGE UNIT PLAN – UNIT 124 ANDREWS DRIVE

REVISIONS:	SCALE: 1'=20'	DATE: 9/24/13
	DRAWN BY: TRB	CHK'D BY: JRA
44 Andrews	JOB: 2004-439	FILE: PHASE4D_REV

Andrews Survey & Engineering, Inc.
Land Surveying – Civil Engineering – Site Planning
P.O. Box 312, 104 Mendon Street
Uxbridge, Massachusetts 01569-0312
P: 508-278-3897 F: 508-278-2289

ATTEST: WORC. Anthony J. Vigliotti, Register