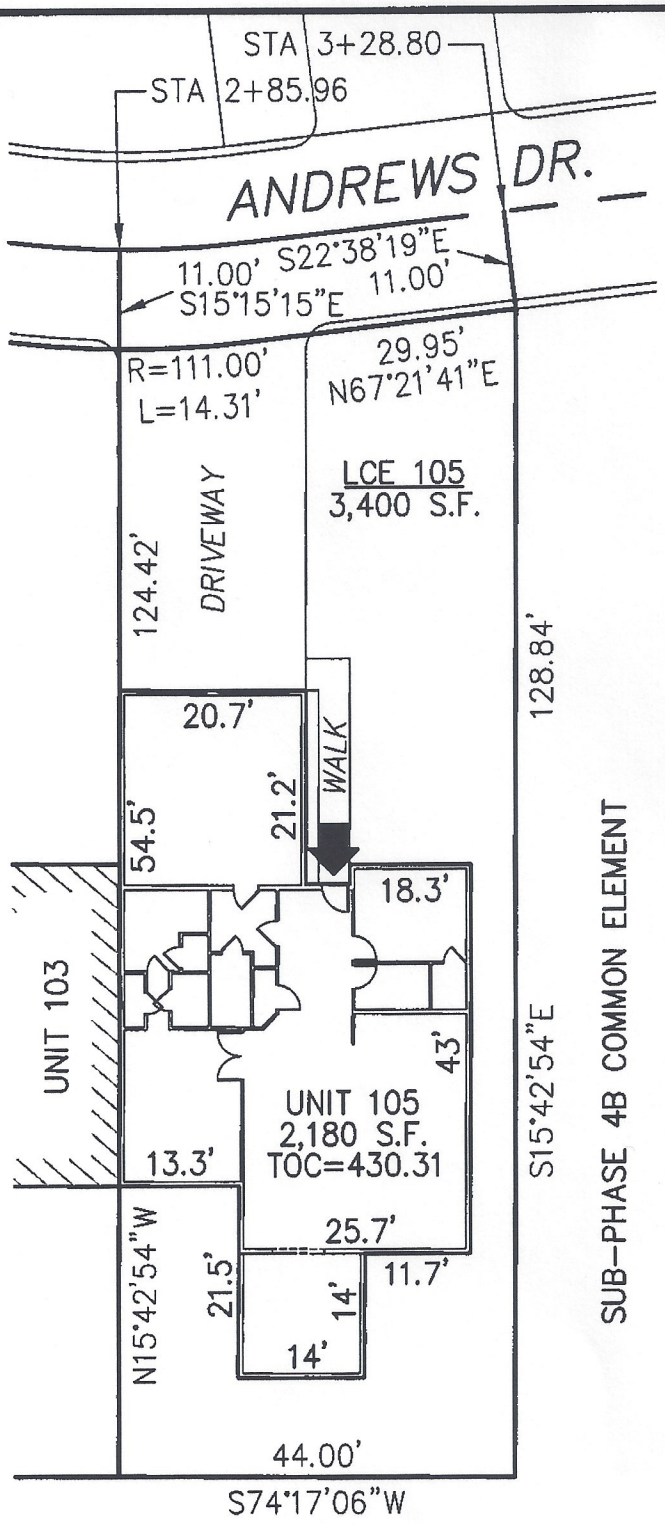

DECLARATION LEGEND

SUB-PHASE 4B
LCE 105 = 3,400 S.F.
COMMON ELEMENT = 215,441± S.F.

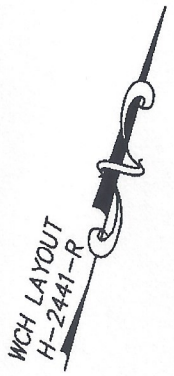

PLAN REFERENCE:
PLAN BOOK , PLAN

I CERTIFY THAT THIS PLAN SHOWS THE UNIT BEING CONVEYED AND OF IMMEDIATE ADJOINING UNITS, AND THAT IT FULLY AND ACCURATELY DEPICTS THE LAYOUT, LOCATION, DIMENSIONS, APPROXIMATE AREA, UNIT NUMBER, MAIN ENTRANCE, AND IMMEDIATE COMMON AREA TO WHICH IT HAS ACCESS, AS BUILT.

COMMONWEALTH OF MASSACHUSETTS
JOHN R. ANDREWS, III
No. 29282
REGISTERED LAND SURVEYOR

6/30/08

JOHN R. ANDREWS, III, P.L.S. DATE

SUMMERFIELD AT TAFT HILL CONDOMINIUM – SUB-PHASE 4B
ANDREWS DRIVE, UXBRIDGE, MA

VILLAGE UNIT PLAN – UNIT 105 ANDREWS DRIVE

REVISIONS:	SCALE: 1'=20'	DATE: 6-30-08
	DRAWN BY: TRB	CHK'D BY: JRA
17 Andrews Drive	JOB: 2004-439	FILE: PHASE4B_REV

Andrews Survey & Engineering, Inc.
Land Surveying | Civil Engineering | Site Planning
P.O. Box 312, 164 Mendon Street
Uxbridge, Massachusetts 01569-0312
P: 508-278-3897 F: 508-278-2289

ATTEST: WORC. Anthony J. Vigliotti, Register