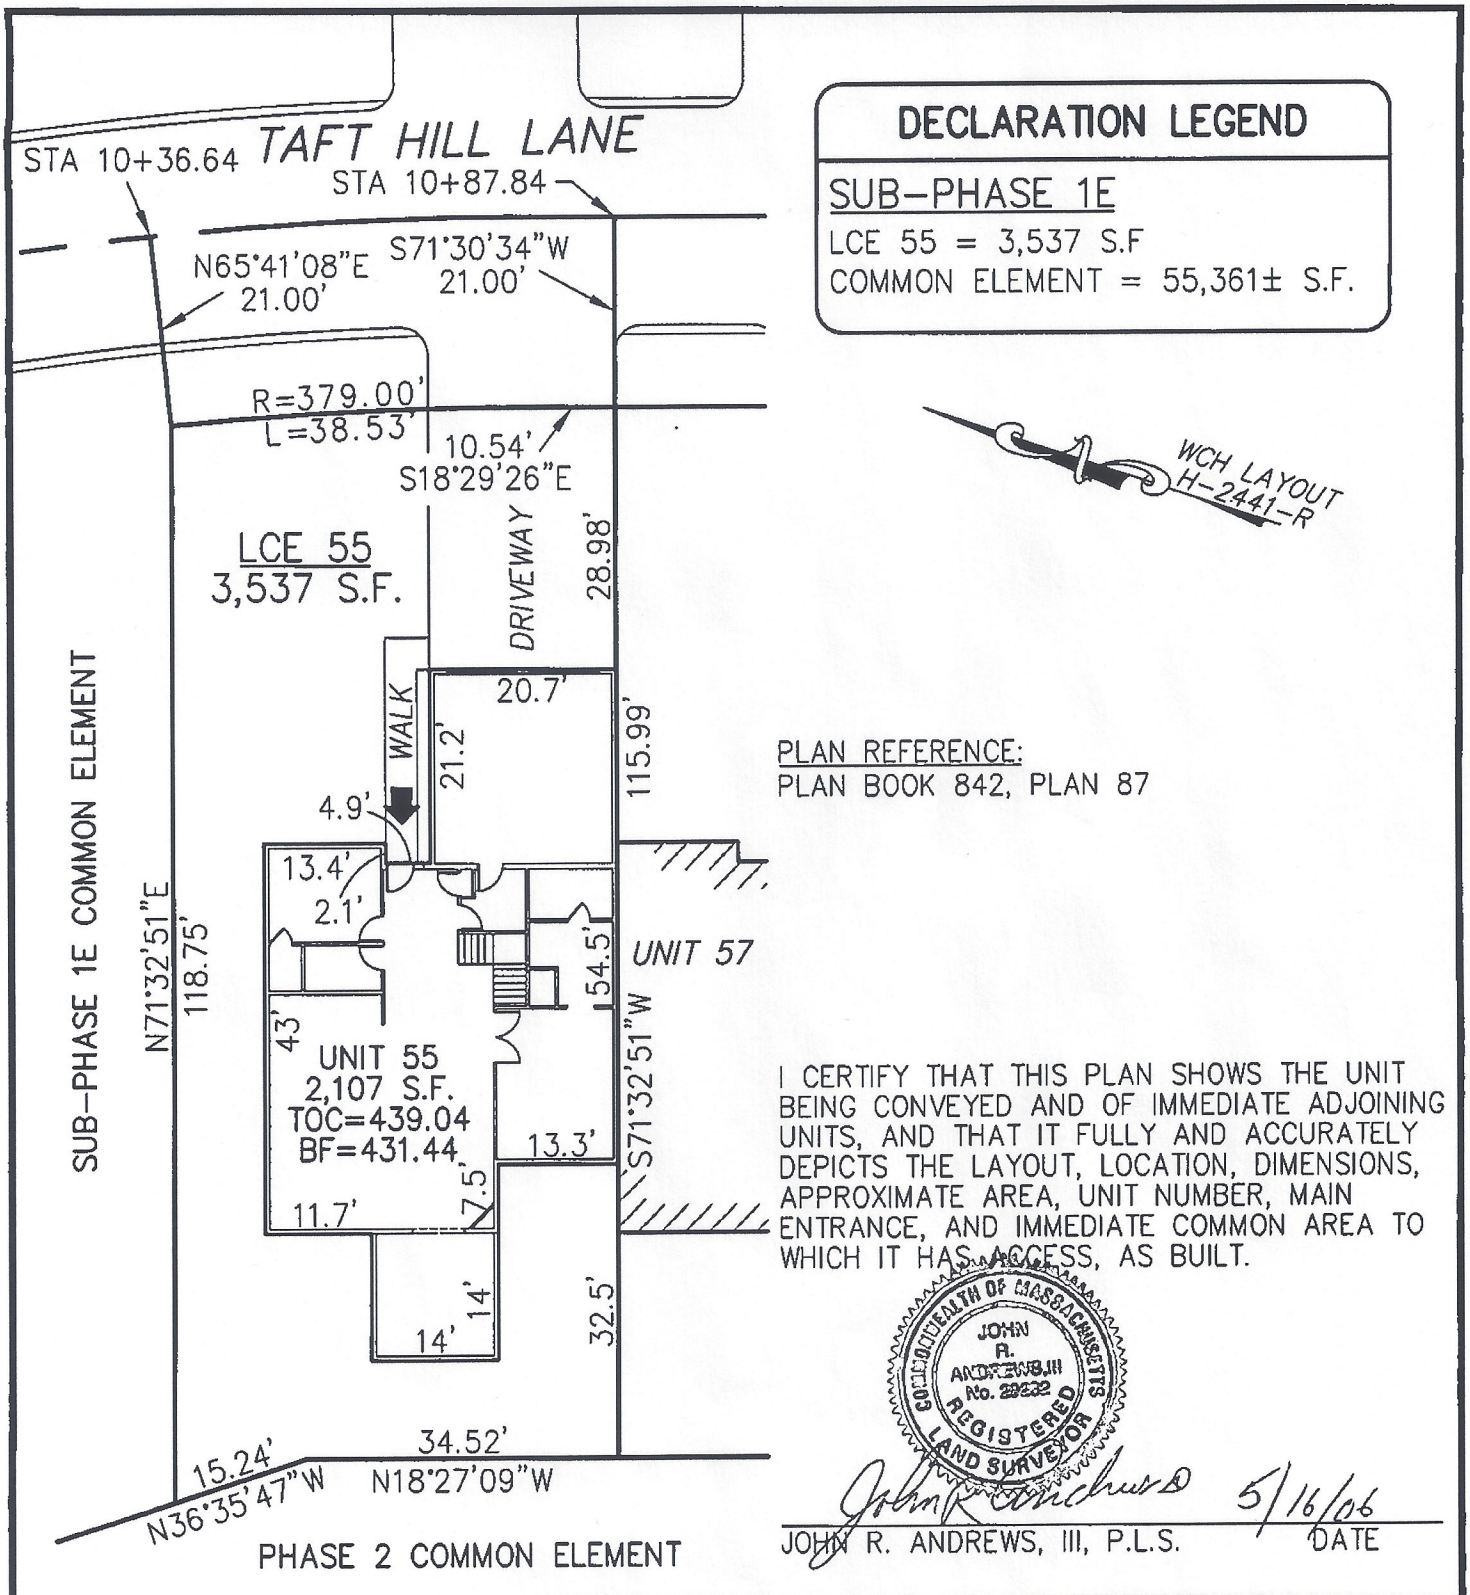

DECLARATION LEGEND

SUB-PHASE 1E

LCE 55 = 3,537 S.F

COMMON ELEMENT = 55,361± S.F.

PLAN REFERENCE:
PLAN BOOK 842, PLAN 87

I CERTIFY THAT THIS PLAN SHOWS THE UNIT BEING CONVEYED AND OF IMMEDIATE ADJOINING UNITS, AND THAT IT FULLY AND ACCURATELY DEPICTS THE LAYOUT, LOCATION, DIMENSIONS, APPROXIMATE AREA, UNIT NUMBER, MAIN ENTRANCE, AND IMMEDIATE COMMON AREA TO WHICH IT HAS ACCESS, AS BUILT.

COMMONWEALTH OF MASSACHUSETTS
JOHN R. ANDREWS, III
No. 29232
REGISTERED LAND SURVEYOR

John R. Andrews 5/16/06

JOHN R. ANDREWS, III, P.L.S. DATE

SUMMERFIELD AT TAFT HILL CONDOMINIUM – SUB-PHASE 1E
TAFT HILL LANE, UXBRIDGE, MA

VILLAGE UNIT PLAN – 55 TAFT HILL LANE

REVISIONS:	SCALE: 1'=20'	DATE: 5-15-06
	DRAWN BY: SJO	CHK'D BY: JRA
55 Taft Hill Lane	JOB: 2004-439	FILE: phase1E_rev

Andrews Survey & Engineering, Inc.
Land Surveying - Civil Engineering - Site Planning
P.O. Box 312, 104 Mendon Street
Uxbridge, Massachusetts 01569-0312
P: 508-278-3897 F: 508-278-2289

ATTEST: WORC. Anthony J. Vigliotti, Register