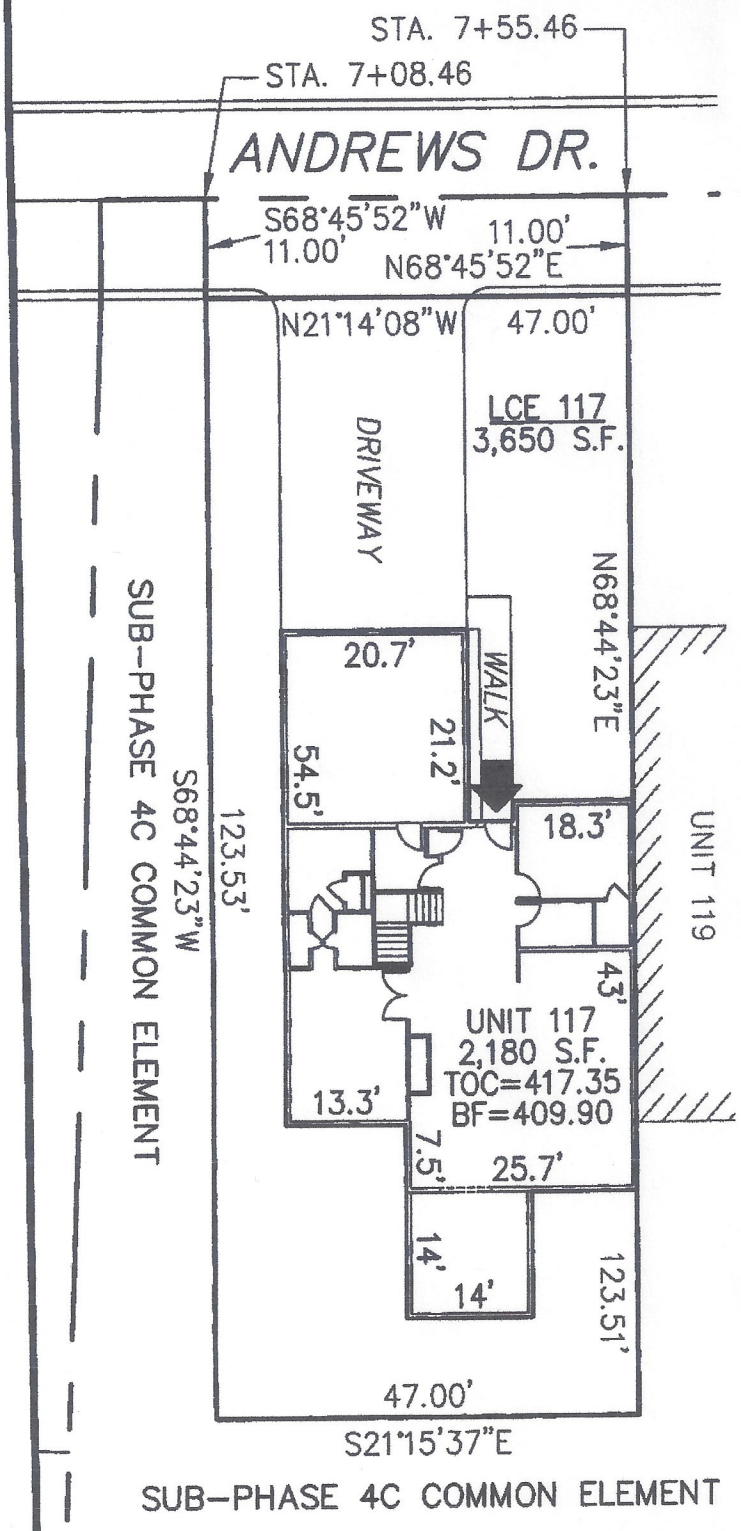

DECLARATION LEGEND

SUB-PHASE 4C
LCE 117 = 3,650 S.F.
COMMON ELEMENT = 78,166± S.F.

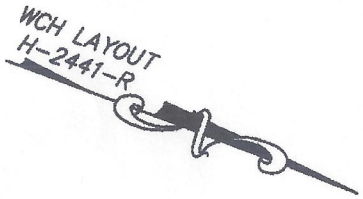

PLAN REFERENCE:
PLAN BOOK , PLAN

I CERTIFY THAT THIS PLAN SHOWS THE UNIT BEING CONVEYED AND OF IMMEDIATE ADJOINING UNITS, AND THAT IT FULLY AND ACCURATELY DEPICTS THE LAYOUT, LOCATION, DIMENSIONS, APPROXIMATE AREA, UNIT NUMBER, MAIN ENTRANCE, AND IMMEDIATE COMMON AREA TO WHICH IT HAS ACCESS, AS BUILT.

COMMONWEALTH OF MASSACHUSETTS
JOHN R. ANDREWS, III
No. 29282
REGISTERED LAND SURVEYOR

John R. Andrews 12/19/07
JOHN R. ANDREWS, III, P.L.S. DATE

SUMMERFIELD AT TAFT HILL CONDOMINIUM – SUB-PHASE 4C
ANDREWS DRIVE, UXBRIDGE, MA

VILLAGE UNIT PLAN – UNIT 117 ANDREWS DRIVE

REVISIONS:	SCALE: 1'=20'	DATE: 12-18-07
	DRAWN BY: TRB	CHK'D BY: JRA
37 Andrews Drive	JOB: 2004-439	FILE: PHASE4C

Andrews Survey & Engineering, Inc.
Land Surveying | Civil Engineering | Site Planning
P.O. Box 312, 101 Mendon Street
Uxbridge, Massachusetts 01569-0312
P: 508-278-3897 F: 508-278-2289