SUB-PHASE 2C COMMON ELEMENT

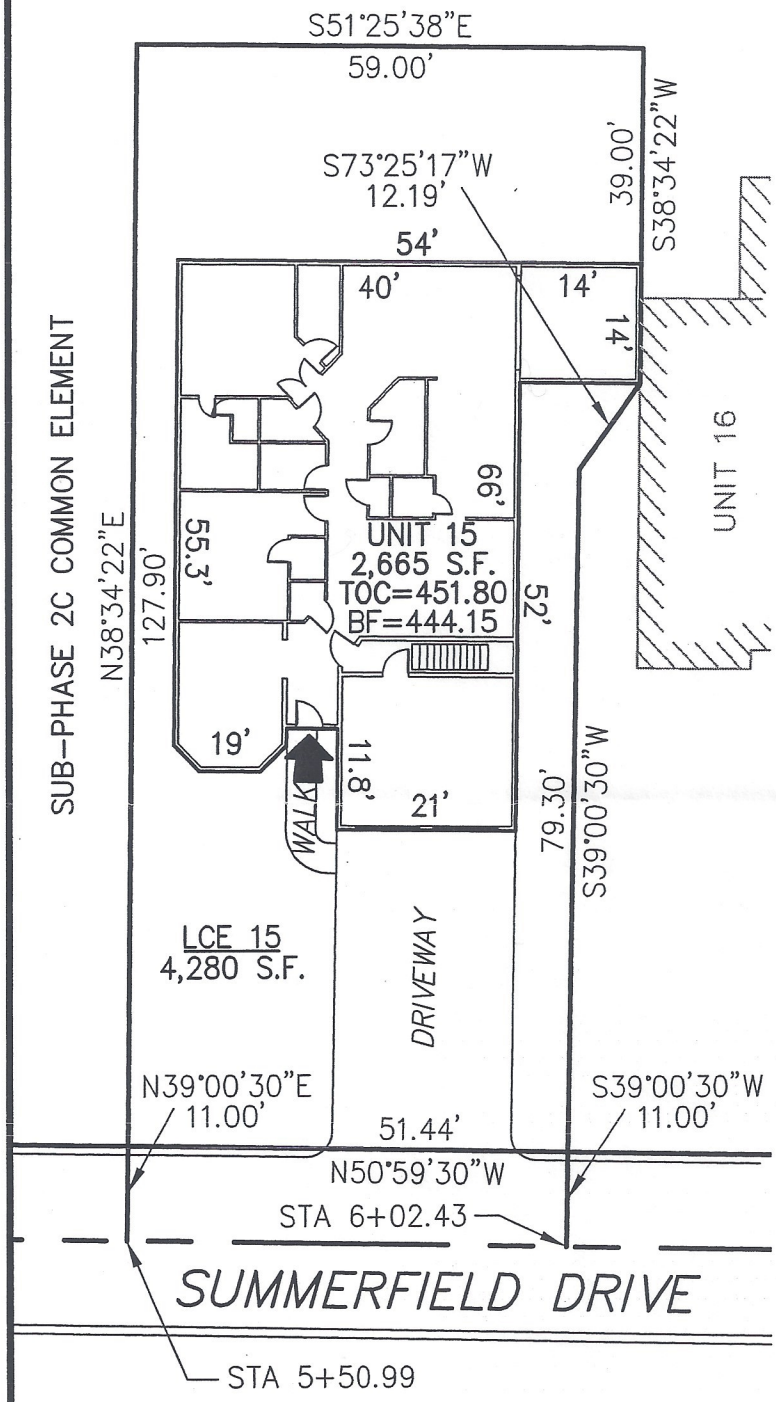

DECLARATION LEGEND

SUB-PHASE 2C

LCE 20 = 4,280 S.F

COMMON ELEMENT = 46,274± S.F.

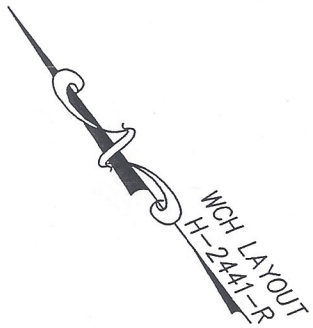

PLAN REFERENCE:
PLAN BOOK , PLAN

I CERTIFY THAT THIS PLAN SHOWS THE UNIT BEING CONVEYED AND OF IMMEDIATE ADJOINING UNITS, AND THAT IT FULLY AND ACCURATELY DEPICTS THE LAYOUT, LOCATION, DIMENSIONS, APPROXIMATE AREA, UNIT NUMBER, MAIN ENTRANCE, AND IMMEDIATE COMMON AREA TO WHICH IT HAS ACCESS, AS BUILT.

COMMONWEALTH OF MASSACHUSETTS
JOHN R. ANDREWS, III
No. 29282
REGISTERED LAND SURVEYOR

11/1/06

JOHN R. ANDREWS, III, P.L.S. DATE

SUMMERFIELD AT TAFT HILL CONDOMINIUM – SUB-PHASE 2C
SUMMERFIELD DRIVE, UXBRIDGE, MA

FAIRWAY UNIT PLAN – UNIT 15 SUMMERFIELD DR.

REVISIONS:	SCALE: 1'=20'	10-31-06
	DRAWN BY: TRB	CHK'D BY: JRA
30 Summerfield	JOB: 2004-439	FILE: phase2C_revised(2)

Andrews Survey & Engineering, Inc.
Land Surveying – Civil Engineering – Site Planning
P.O. Box 312, 104 Mendon Street
Uxbridge, Massachusetts 01569-0312
P: 508-278-3897 – F: 508-278-2289